

KANSAS

Greenwood

Section 27 Township 22 Range 11-E

Well No. #11 Wick

Company Skelly

Miscellaneous

NORTH

				0			

WEST

EAST

SOUTH

2

Greenwood **KANSAS**

Sec. 27 Twp. 22 R. 11E

Well No. #11 Wick Farm
Skelly Company

Miscellaneous


990' Ft. from N. Line

 Ft. from S. Line

 Ft. from E. Line

330' Ft. from W. Line

SW NW NE

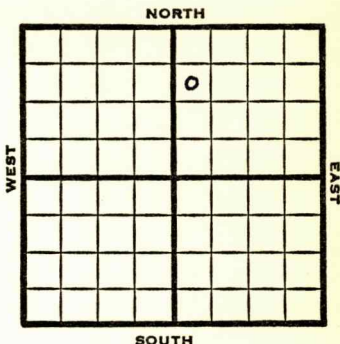

1949 **Elev. 1227'** REPORT

11/23 8" @ 77'
Lans. 1024'
KC 1277'
Bart 1846'
TD 1933'
5" @ 1917'
11/29 TD 1944' SSO
12/7 63 qts 1935'-60'
CO
12/14 **Bart 1846'**
5" @ 1917'
63 qts
Pump 2 oil & 3 W Pot.
Gr. 38°
TD 1944'

COMPLETED

Kansas

Miscellaneous

Map No. _____ Sec. 27 Twp. 22 R. 11EWell No. 11 Wick

Skelly

Company

COMPLETE

Contractor

SW NW NE

F. 122?
SECTION PLAT

		0	

990 Ft. from N. Line

_____ Ft. from S. Line

_____ Ft. from E. Line

330 Ft. from W. Line

Greenwood County

Location _____

Rig up _____

Drilling and Remarks:

*Bar 1846**5" C 1917**689 to**Prod 2016 13 W 1/4**382 1/4*

RECORD

Cased _____ in., _____ ft.

Sand _____

Gas _____

Oil _____

Total Depth 1944

PRODUCTION

1st 24 hrs. Nat. _____

1st 24 hrs. after shot _____

Gas _____ Cu. Ft.

Dry Hole _____

Abandoned _____

Date

DEC 14 1949

19

S. J. LEWIS

Scout

Map No. _____ Sec. 27 Twp. 22 R. 11E

Well No. 11 Wick

Skelly Company

Contractor

**FIRST REPORT
SECTION PLAT**


SW NW NE

990 Ft. from N. Line

_____ Ft. from S. Line

_____ Ft. from E. Line

330 Ft. from W. Line

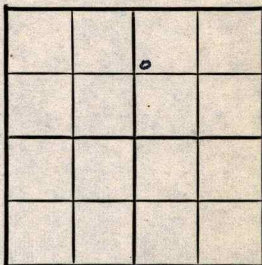

Greenwood County

Location _____

Rig up _____

Drilling and Remarks:

8" @ 77

Lans. 1024

KC 1277

Bart. 1846

TD 1933

5" @ 1917

RECORD

Cased _____ in., _____ ft.

Sand _____

Gas _____

Oil _____

Total Depth _____

PRODUCTION

1st 24 hrs. Nat. _____

1st 24 hrs. after shot _____

Gas _____ Cu. Ft.

Dry Hole _____

Abandoned _____

Date

NOV 23 1949

19

S. J. LEWIS

Scout