


Map No. 71 Sec. 27 Twp. 22 R. 11
Well No. 13 Wick Farm _____
Shelly Oil Company _____

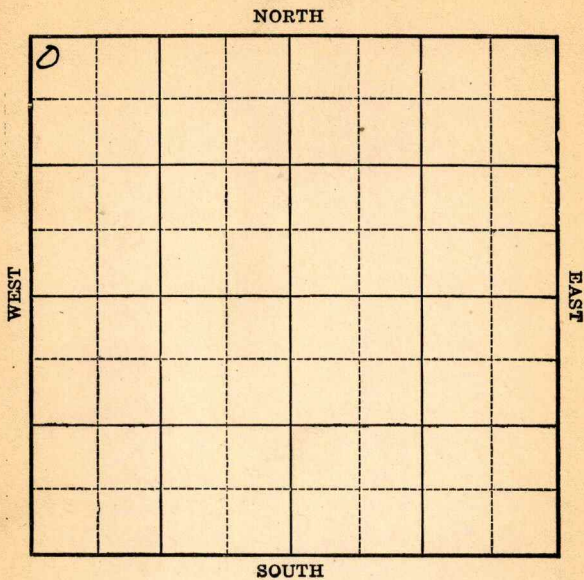

Location _____

Rig up _____

Drilling Remarks:

Drilling Remarks:

RECORD

PRODUCTION

Cased _____ in. _____ ft.

1st 24 hrs Nat. _____

Sand _____

1st 24 hrs. after shot _____

Gas _____

Gas _____ cu. ft.

Oil _____

Dry Hole _____

Total Depth _____

Abandoned _____

Map No. **KANSAS** ²¹ Sec. **27** Twp. **22** R. **11**

Well No. **13 Wick**

skelly oil Company

Contractor

COMPLETED SECTION PLAT

330 Ft. from N. Line

----- Ft. from S. Line

----- Ft. from E. Line

330 Ft. from W. Line

0			

Location -----

Rig up -----

Drilling and Remarks:

sand 1918-24
40/40 lbs

RECORD

Cased ----- in., ----- ft.

Sand -----

Gas -----

Oil -----

Total Depth -----

PRODUCTION

1st 24 hrs. Nat. -----

1st 24 hrs. after shot -----

Gas ----- Cu. Ft.

Dry Hole -----

Abandoned -----

Date

AUG 6 1924

192

M. A. BENEAR

Scout

21 **KANSAS** Map No. Sec. 27 Twp. 22 R. 11

Well No. 13 Wick

skully oil Company

Contractor

FIRST REPORT

330 Ft. from N. Line

Ft. from S. Line

Ft. from E. Line

330 Ft. from W. Line

SECTION PLAT

0			

Location ✓ ✓

Rig up

Drilling and Remarks:

RECORD

Cased in, ft.

Sand

Gas

Oil

Total Depth

PRODUCTION

1st 24 hrs. Nat.

1st 24 hrs. after shot

Gas Cu. Ft.

Dry Hole

Abandoned

Date JUN 10 1924

M. A. BENTAR