


Greenwood

Map No. *Kans* Sec. *27* Twp. *22* R. *11*

Well No. *14 Wick* Farm

Stelly Company

NORTH

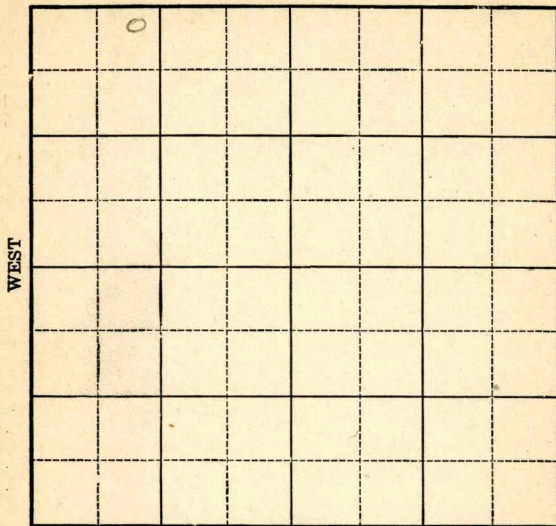

Location _____

Drilling Remarks _____

Rig Up _____

Drilling Remarks _____

RECORD

Cased _____ in. _____ ft.

Sand _____

Gas _____

Oil _____

Total Depth _____

PRODUCTION

1st 24 hrs. Nat. _____

1st. 24 hrs. after shot _____

Gas _____ cu. ft.

Dry Hole _____

Abandoned _____

21 **KANSAS** Map No. Sec. 27 Twp. 22 R. 11E

Well No. 14 Wick

skelly oil

Company

Contractor

COMPLETED

SECTION PLAT

330' Ft. from N. Line

Ft. from S. Line

Ft. from E. Line

990' Ft. from W. Line

0			

Location

Rig up

Drilling and Remarks:

shot 40 gts.

RECORD

Cased in., ft.

Sand

Gas

Oil 1926-1940

Total Depth 1943

PRODUCTION

1st 24 hrs. Nat.

1st 24 hrs. after shot 25

Gas Cu. Ft.

Dry Hole

Abandoned

Date

APR 6 1925

M. A. BENEAR

Scout

Greenwood Co.

Map No. **KANSAS** Sec. *27* Twp. *22* R. *11*

Well No. *14 Wick*

Skelley Company

Contractor

FIRST REPORT

SECTION PLAT

330 Ft. from N. Line

----- Ft. from S. Line

----- Ft. from E. Line

990 Ft. from W. Line

○			

Location *✓✓*

Rig up -----

Drilling and Remarks:

RECORD

Cased ----- in., ----- ft.

Sand -----

Gas -----

Oil -----

Total Depth -----

PRODUCTION

1st 24 hrs. Nat. -----

1st 24 hrs. after shot -----

Gas ----- Cu. Ft.

Dry Hole -----

Abandoned -----

Date

2/8 1925

M. A. BENEAR

Scout