


Map No. **KANSAS** Sec. 27 Twp. 22 R. 41E

Well No. 20 Wick Farm
Kelly & Tidal Company

NORTH

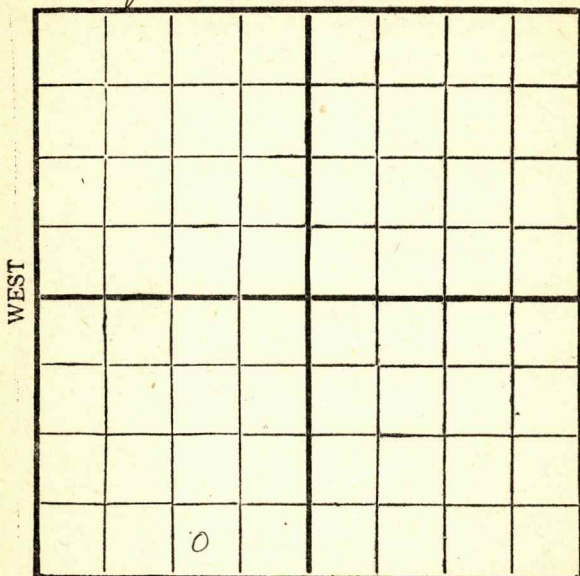

14

SOUTH

Location _____

Drilling Remarks

Rig Up _____

Drilling Remarks

RECORD

Cased _____ in. _____ ft.

Sand _____

Gas _____

Oil _____

Total Depth _____

PRODUCTION

1st 24 hrs. Nat. _____

1st 24 hrs. after shot _____

Gas _____ cu. ft. _____

Dry Hole _____

Abandoned _____

Greenwood

Map No. **KANSAS** Sec. *27* Twp. *22* R. *11^E*

Well No. *20- Vick* Farm
Skelly & Tedal Company


_____ Ft. from N. Line

250 Ft. from S. Line

1070 Ft. from E. Line

_____ Ft. from W. Line

1930

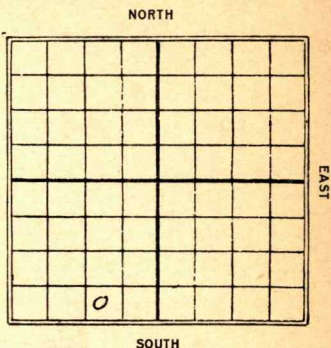

Date	REPORT
<i>3/5</i>	<i>Location</i>
<i>3/12</i>	<i>Rig.</i>
<i>3/19</i>	<i>Splg 200'</i>
<i>3/26</i>	<i>Fsg. 550'</i>
<i>4/2</i>	<i>Wdg. 1645'</i>
<i>4/9</i>	<i>Sahed 1882-1891'</i>
	<i>Sdy shale 1891-1931</i>
	<i>T.D. 1963 - Shot</i>
	<i>100 gts Swab 42</i>
	<i>gals - 2 hrs.</i>
<i>4/16</i>	<i>Sand 1882-1963</i>
	<i>TD 1963</i>
	<i>P.B. to 1942</i>
	<i>Shot 100 gt</i>
	<i>60 bbl oil</i>
	<i>Somp.</i>

Greenwood

21 Map No. Sec. 27 Twp. 22 R. 11^E

Well No. 20 Wick

Skelly & Jidal Company

Contractor

FIRST REPORTS

SECTION PLAT

Ft. from N. Line

250 Ft. from S. Line

1070 Ft. from E. Line

Ft. from W. Line

	0		

Location ✓

Rig up

Drilling and Remarks:

RECORD

Cased in., ft.

Sand

Gas

Oil

Total Depth

PRODUCTION

1st 24 hrs. Nat.

1st 24 hrs. after shot

Gas Cu. Ft.

Dry Hole

Abandoned

Date

MAR 5 1930

CHAS. L. SHERWOOD

192 Scout

Greenwood

Map No. **KANSAS** Sec. 27 Twp. 22 R. 11

Well No. 21 20 Wick Company

Stelly & Judel Contractor

COMPLETE

SECTION PLAT

.....Ft. from N. Line

250 Ft. from S. Line

1070 Ft. from E. Line

.....Ft. from W. Line

	0		

Location.....

Rig up.....

Drilling and Remarks:

PB to 1942

100/60 Blo.

RECORD

Cased.....in.,.....ft.

Sand 1882-1963

Gas.....

Oil.....

Total Depth 1963

PRODUCTION

1st 24 hrs. Nat.....

1st 24 hrs. after shot.....

Gas.....Cu. Ft.

Dry Hole.....

Abandoned.....

Date

APR 16 1930

192.....**CHAS. L. SHERWOOD** Scout