


Map No. *KAN* Sec. *27* Twp. *22* R. *11*
Well No. *16* *Wick* Farm
Tidal & Skelly Company
NORTH

NORTH

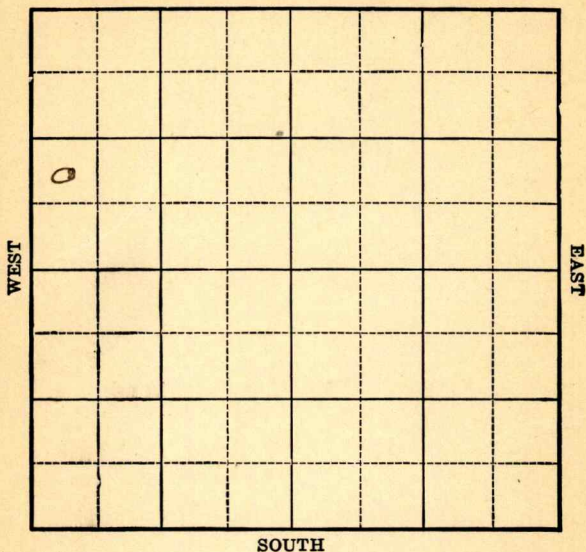

Location -----

Drilling Remarks

Rig Up-----

Drilling Remarks

RECORD

Cased_____in. _____ft.

Sand

Gas

Oil _____

Total Depth _____

PRODUCTION

1st 24 hrs. Nat.-----

1st 24 hrs. after shot_____


Gas_____cu. ft.

Dry Hole

Abandoned -----

*Greenwood*Map No. *1000* Sec. *27* Twp. *22* R. *11*Well No. *16 - Wick* Farm*Tidal & Skelly* Company

NORTH

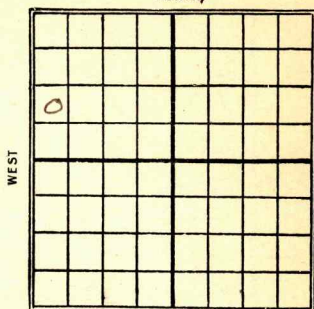

Ft. from N. Line

990 Ft. from S. Line

Ft. from E. Line

330 Ft. from W. Line*1926*

Date

REPORT

9/1 Rig up
9/16 S.O. 340
9/22 Dug 1010
9/29 " 1360
10/13 Sand 1900-1938
160/300 barrels

Well No. 16 Mark Farm

Company

COMPLETED

WEST

EAST

SOUTH

Location

Rig up

Drilling and Remarks:

RECORD

Cased in., ft.

Sand 1900-1928

Gas

Oil

Total Depth 1942

PRODUCTION

1st 24 hrs. Nat.

1st 24 hrs. after shot

Gas	Cu. Ft.

Dry Hole

Abandoned

Date _____

OCT 13 1926 CHAS. L. SHERWOOD Scout

Scout

Solomonwood

21 **KANSAS** Map No. _____ Sec. 27 Twp. 22 R. 11Well No. 16 Nick
Tidal & Skelly Company

Contractor _____

FIRST REPORTS**SECTION PLAT**

0			

_____ Ft. from N. Line

990 _____ Ft. from S. Line

_____ Ft. from E. Line

330 _____ Ft. from W. Line

Location _____

Rig up _____

Drilling and Remarks:

RECORD

Cased _____ in., _____ ft.

Sand _____

Gas _____

Oil _____

Total Depth _____

PRODUCTION

1st 24 hrs. Nat. _____

1st 24 hrs. after shot _____

Gas _____ Cu. Ft.

Dry Hole _____

Abandoned _____

Date

SEP 1 1926

192

CHAS. L. SHERWOOD

Scout