


Map No. **KANSAS** Sec. *27* Twp. *22* R. *11^E*

Well No. *21- Wick* Farm

Spelly & Tidal Company

NORTH

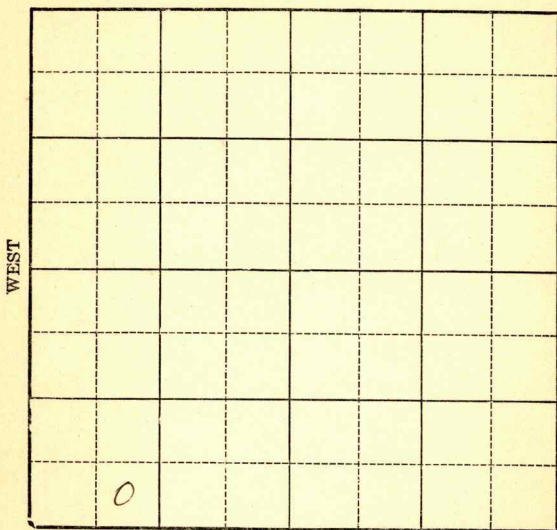

13

Location _____
Drilling Remarks _____

Rig Up _____
Drilling Remarks _____

RECORD

PRODUCTION

Cased _____ in. _____ ft.
Sand _____
Gas _____
Oil _____
Total Depth _____

1st 24 hrs. Nat. _____
1st 24 hrs. after shot _____
Gas _____ cu. ft. _____
Dry Hole _____
Abandoned _____

Greenwood

Map No. **KANSAS** Sec. 27 Twp. 22 R. 11^E

Well No. 21 Wick

Shelly & Jidal Company

Contractor

FIRST REPORTS

SECTION PLAT

Ft. from N. Line

330 Ft. from S. Line

Ft. from E. Line

990 Ft. from W. Line

0			

Location

Rig up ✓

Drilling and Remarks:

RECORD

Cased in., ft.

Sand

Gas

Oil

Total Depth

PRODUCTION

1st 24 hrs. Nat.

1st 24 hrs. after shot

Gas Cu. Ft.

Dry Hole

Abandoned

Date

APR 23 1930

CHAS. L. SHERWOOD

Lynnwood

21 **KANSAS** Sec. 27 Twp. 22 R. 11

Well No. 21 Wick
Skelly & Jidal Company

Contractor

COMPLETE

SECTION PLAT

_____ Ft. from N. Line

330 Ft. from S. Line

_____ Ft. from E. Line

990 Ft. from W. Line

o			

Location _____

Rig up _____

Drilling and Remarks:

260/135 Bbs.

RECORD

Cased _____ in., _____ ft.

Sand 1883-1944

Gas _____

Oil _____

Total Depth 1949

PRODUCTION

1st 24 hrs. Nat. _____

1st 24 hrs. after shot _____

Gas _____ Cu. Ft.

Dry Hole _____

Abandoned _____

Date

MAY 28 1930

CHAS. L. SHERWOOD