

Greenwood

Form 252-A
5M 4-32 MPC

Map No. **KANSAS** Sec. 27 Twp. 22^S R. 11^E

Well No. # 25 Wick Farm _____


Skelly Oil Company _____

_____ Ft. from N. Line

990 Ft. from S. Line

_____ Ft. from E. Line

990 Ft. from W. Line

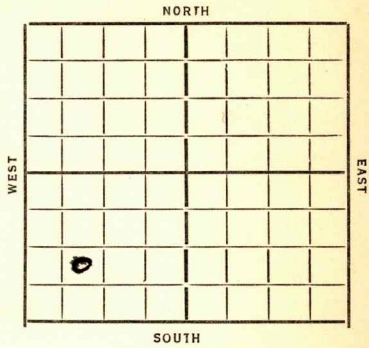

Date 1933

REPORT

10/18 Cellar

10/25 Spudding

11/1 Hrlg 600

11/8 " 1030

11/15 Bartville 1878 - Run 6"

11/22 Pay 1892-1984 - shot 20 gts
Swab 41 bbl oil + 21 bbl water

11/29 — 12/6 —

12/13 sand 1878 J.D. 1984 - 50 bbl oil + some water

COMPLETED

Map No. 21 Sec. 27 Twp. 22 R. 11E

Well No. 25-Whit

Skelly oil

Company

Contractor

COMPLETED

SECTION PLAT

..... Ft. from N. Line

990 Ft. from S. Line

..... Ft. from E. Line

990 Ft. from W. Line

0			

Location.....

Rig up.....

Drilling and Remarks:

50 lbs oil
some water

RECORD

Cased..... in. ft.

Sand 1878

Gas.....

Oil.....

Total Depth 1984

PRODUCTION

1st 24 hrs. Nat.....

1st 24 hrs. after shot.....

Gas..... Cu. Ft.

Dry Hole.....

Abandoned.....

Date

12-13-33 192

O. Manschub
Scout

Map No. 21 Sec. 27 Twp. 22 R. 11E

Well No. 25-Wick

Skelly oil Company

Contractor

see

..... Ft. from N. Line

990 Ft. from S. Line

..... Ft. from E. Line

990 Ft. from W. Line

SECTION PLAT

FIRST REPORTS

Location.....

Rig up.....

Drilling and Remarks:

cellar

RECORD

Cased..... in., ft.

Sand.....

Gas.....

Oil.....

Total Depth.....

PRODUCTION

1st 24 hrs. Nat.....

1st 24 hrs. after shot.....

Gas..... Cu. Ft.

Dry Hole.....

Abandoned.....

Date

10-28-33 192.....

O. Mannebeck Seout