


Greenwood

Form 51-5M-11-31-Palace

Map No. **KANSAS** Sec. 27 Twp. 22 R. 11

Well No. 26 work Farm
Shelly Oil Company

NORTH

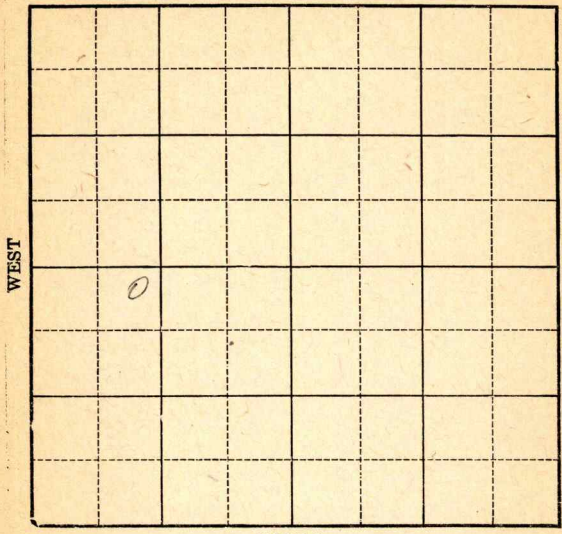

Location _____

Drilling Remarks _____

Rig Up _____

Drilling Remarks _____

RECORD

Cased _____ in. _____ ft.

Sand _____

Gas _____

Oil _____

Total Depth _____

PRODUCTION

1st 24 hrs. Nat. _____

1st 24 hrs. after shot _____

Gas _____ cu. ft.

Dry Hole _____

Abandoned _____

Greenwood

Map No. **KANSAS** Sec. *27* Twp. *22* R. *11* ^E

Well No. *26 - Wick* Farm


Shelly Oil Company

250' Ft. from N. Line

_____ Ft. from S. Line

_____ Ft. from E. Line

1070' Ft. from W. Line

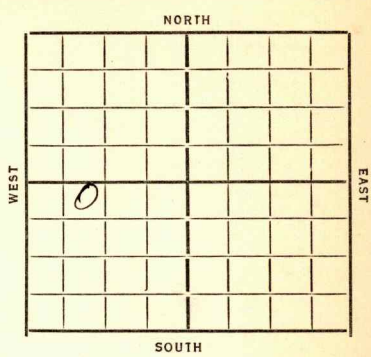

Date *1/23*

REPORT

12/13 Spud

12/27 Hrlg 1035 12" 638

1/4 8" at 1617 - 6" 1877

1/11 Rivile 1880 - em 6" woc

1/17 T.D. 1968 - shot 60 gts and 30 gts - e.o.

1/24 50 bbls in 10 hrs.

1/31 Sand 1880 TD 1968 60 qt shot 30 qt shot 60 Bbls.

COMPLETED

Map No. 21 Sec. 27 Twp. 22 R. 11E

Well No. 26-Wick

Skelly oil Company

Contractor

COMPLETED

250 Ft. from N. Line

..... Ft. from S. Line

..... Ft. from E. Line

1070 Ft. from W. Line

SECTION PLAT

0			

Location.....

Rig up.....

Drilling and Remarks:

60 qt shot
30 qt "

60 bbls

RECORD

Cased..... in., ft.

Sand 1880

Gas.....

Oil.....

Total Depth 1968

PRODUCTION

1st 24 hrs. Nat.....

1st 24 hrs. after shot.....

Gas..... Cu. Ft.

Dry Hole.....

Abandoned.....

Date

1-31-34 192 O. Mannick Scout

Map No. 21 Sec. 27 Twp. 22 R. 11E

Well No. 26- Wick

Spelly oil

Company

Contractor

FIRST REPORTS

SECTION PLAT

250 Ft. from N. Line

..... Ft. from S. Line

..... Ft. from E. Line

1070 Ft. from W. Line

0			

Location.....

Rig up.....

Drilling and Remarks:

Mud

RECORD

Cased..... in., ft.

Sand.....

Gas.....

Oil.....

Total Depth.....

PRODUCTION

1st 24 hrs. Nat.....

1st 24 hrs. after shot.....

Gas..... Cu. Ft.

Dry Hole.....

Abandoned.....

Date

17-13-33 192

O. Manschreck Scout