

Greenwood

Map No. **KANSAS** Sec. *27* Twp. *22* R. *11E*

Well No. *27 Wick* Farm


Skelly oil Company

_____ Ft. from N. Line

990 Ft. from S. Line

990 Ft. from E. Line

_____ Ft. from W. Line

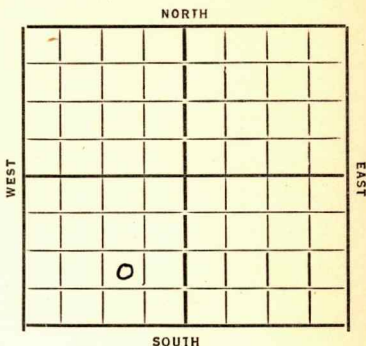

Date
1934

REPORT

2/7 Machine

2/14 Spud

2/23 Dily 1325

3/1 Sand 1879-83 show oil
1883 . 7" 1879

3/8 95 1965 80 gte CO

3/21 Sand 1879-83 95 1965 shot
80 gte 67 oil + 17 water

COMPLETED

Greenwood

Map No. 21 Sec. 27 Twp. 22 R. 11E

Well No. 27-Wick

Shelly Oil

Company

Contractor

COMPLETED

SECTION PLAT

	0		

_____ Ft. from N. Line

990 Ft. from S. Line

990 Ft. from E. Line

_____ Ft. from W. Line

Location _____

Rig up _____

Drilling and Remarks:

80 gts

*67 oil
17 water*

RECORD

Cased _____ in., _____ ft.

Sand 1879-83

Gas _____

Oil _____

Total Depth 1965

PRODUCTION

1st 24 hrs. Nat. _____

1st 24 hrs. after shot _____

Gas _____ Cu. Ft.

Dry Hole _____

Abandoned _____

Date

3/21/34 19 34 *O. Mammuch* 34

Map No. 21 Sec. 27 Twp. 22 R. 11E

Well No. 27- Wick

Spully oil

Company

Contractor

FIRST REPORTS

.....Ft. from N. Line

990 Ft. from S. Line

990 Ft. from E. Line

.....Ft. from W. Line

SECTION PLAT

Location.....

Rig up.....

Drilling and Remarks:

Machine

RECORD

Cased.....in.,ft.

Sand.....

Gas.....

Oil.....

Total Depth.....

PRODUCTION

1st 24 hrs. Nat.....

1st 24 hrs. after shot.....

Gas.....Cu. Ft.

Dry Hole.....

Abandoned.....

Date

2-7-34 1934 O. Manschuet Scout