


Map No. _____ Sec. 27 Twp. 22 R. 11

Well No. 1 Wick Farm _____
Tidal Oil Company _____

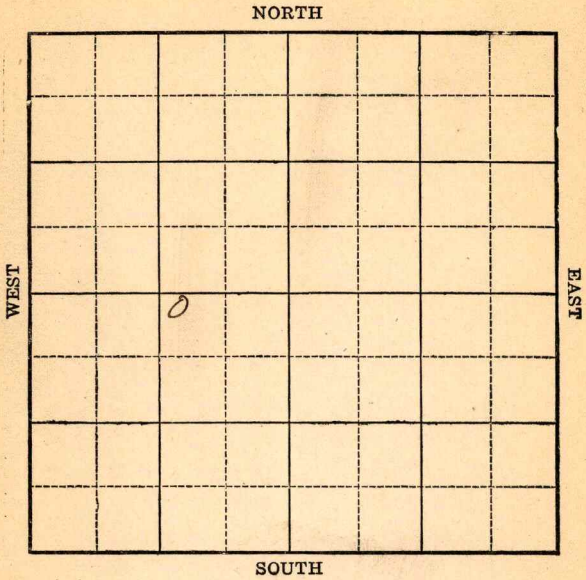

Location _____

Rig up _____

Drilling Remarks:

Drilling Remarks:

RECORD

PRODUCTION

Cased _____ in. _____ ft.

Sand _____

Gas _____

Oil _____

Total Depth _____

1st 24 hrs Nat. _____

1st 24 hrs. after shot _____

Gas _____ cu. ft.

Dry Hole _____

Abandoned _____

Map No. _____ Sec. 27 Twp. 22 R. 11

Well No. 1 Wick Farm _____
Tidal Oil Company _____


NORTH

200 Ft. from N. Line

_____ Ft. from S. Line

1120 Ft. from E. Line

_____ Ft. from W. Line

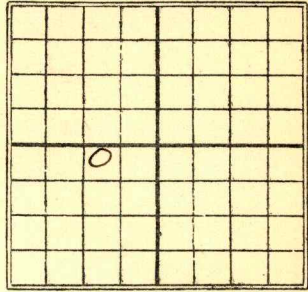

SOUTH

Date
1923

REPORT

1/12 Sand 1947-64 - Est. 180
Bbls. ID 1965

Map No. **KANSAS** *21* Sec. *27* Twp. *22* R. *11*

Well No. *1 Wick*

Tidal air Company

Completed Contractor

ABANDONED

SECTION PLAT

FIRST REPORT

200 Ft. from N. Line

_____ Ft. from S. Line

1120 Ft. from E. Line

_____ Ft. from W. Line

	0		

Location _____

Rig up _____

Drilling and Remarks:

and 1947
1964
7.0. 1965
est 180 flls

RECORD

Cased _____ in., _____ ft.

Sand _____

Gas _____

Oil _____

Total Depth _____

PRODUCTION

1st 24 hrs. Nat. _____

1st 24 hrs. after shot _____

Gas _____ Cu. Ft.

Dry Hole _____

Abandoned _____

Date

M. A. BENEAR

JAN 12 1923

191

Scout