

Map No. _____ Sec. 27 Twp. 22 R. 11


Well No. 5 Wick Farm _____
Skelly Oil Company _____

_____ Ft. from N, Line

200 Ft. from S. Line

200 Ft. from E. Line

Ft. from W. Line

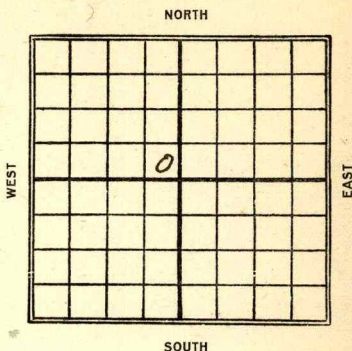

Date 1923

REPORT

3/2	Rgn up.
4/7	J.D. 1921 - J.O. 1929-34 Best Pay 1934-48 - Short 40 gts. 200 Rbl J.D. 1953'

KANSAS

Map No. _____ Sec. 27 Twp. 22 R. 11Well No. 5 Wick

Company _____

Contractor _____

COMPLETED

SECTION PLAT

_____ Ft. from N. Line

200 _____ Ft. from S. Line200 _____ Ft. from E. Line

_____ Ft. from W. Line

Location _____

Rig up _____

Drilling and Remarks:

Top S. 1921F.O. 1929-34Test pay 1934-48J.D. 1953shot 40/200 lbs

RECORD

Cased _____ in., _____ ft.

Sand _____

Gas _____

Oil _____

Total Depth _____

PRODUCTION

1st 24 hrs. Nat. _____

1st 24 hrs. after shot _____

Gas _____ Cu. Ft.

Dry Hole _____

Abandoned _____

Date APR 7 1923

M. A. BENEAR

_____ 191 _____

Scout

Map No. **KANSAS** 21 Sec. 27 Twp. 22 R. 11

Well No. 5 Wick

Skelly Company

Contractor

FIRST REPORT

_____ Ft. from N. Line

200 Ft. from S. Line

200 Ft. from E. Line

_____ Ft. from W. Line

SECTION PLAT

Location _____

Rig up _____

Drilling and Remarks:

Rig up

RECORD

Cased _____ in., _____ ft.

Sand _____

Gas _____

Oil _____

Total Depth _____

PRODUCTION

1st 24 hrs. Nat. _____

1st 24 hrs. after shot _____

Gas _____ Cu. Ft.

Dry Hole _____

Abandoned _____

Date

MAR 2 1923

M. A. BENEAR

191

Scout