

Ks. S. 28 T. 22 S., R. 13 E.

Greenwood County

Sunshine City & Co. Log Boom Company

John Bell #1 Farm

1197 T.D.


Dry

relation by

drilled M&K



Log Boom gives this as John Bell #1.

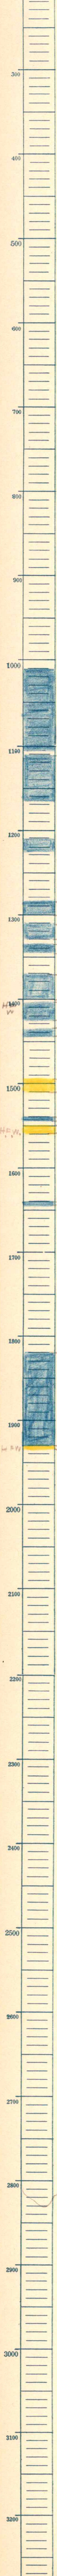

1285
1300
1310
1330
1335
1345

1370

H.F.W. 1400
1405 - H.F.W.
1425
1435
1445

1495
1512

H.F.W. 1540-45
1550
1560 - H.F.W.

1640-45

1820

H.F.W. 1930
1934 H.F.W.