


Map No. Kansas Sec. 28 Twp. 22 R. 12  
Well No. 1 Frankhouser Farm  
J. H. Simmons Company

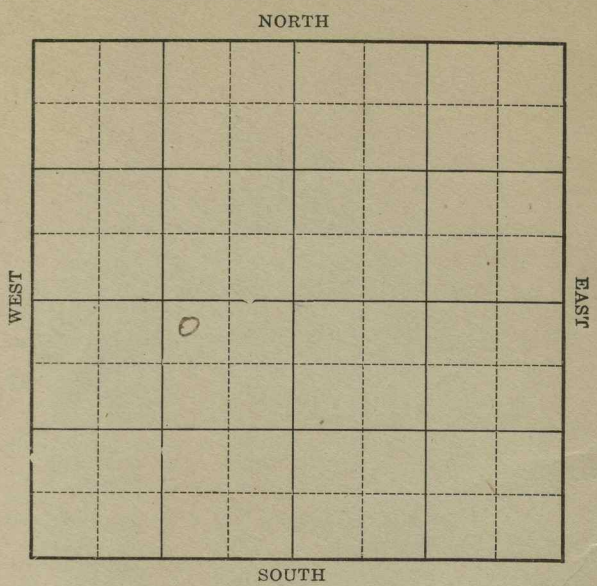


Location \_\_\_\_\_  
Drilling Remarks \_\_\_\_\_  
\_\_\_\_\_

Rig Up \_\_\_\_\_  
Drilling Remarks \_\_\_\_\_  
\_\_\_\_\_

RECORD		PRODUCTION	
Cased	in. _____ ft.	1st 24 hrs. Nat.	_____
Sand	_____	1st 24 hrs. after shot	_____
Gas	_____	Gas	_____ cu. ft.
Oil	_____	Dry Hole	_____
Total Depth	_____	Abandoned	_____

Form 252A-5M-7-25-19684  
Map No. Kansas Sec. 28 Twp. 22 R. 12  
Well No. 1 Frankhouser Farm  
J. H. Simmons Company

300 Ft. from N. Line  
\_\_\_\_\_ Ft. from S. Line  
1120 Ft. from E. Line  
\_\_\_\_\_ Ft. from W. Line

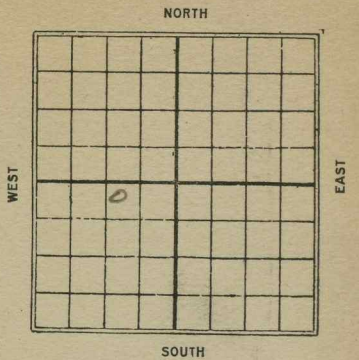

Date	REPORT
<u>1/26</u>	
<u>1/20</u>	<u>Location</u>
<u>1/27</u>	<u>Spudded T.S. 10.</u>
<u>2/4</u>	_____
<u>2/10</u>	_____
<u>2/17</u>	_____
<u>2/24</u>	_____
<u>3/5</u>	<u>Drlg 300' offset.</u>
<u>3/10</u>	<u>Crooked hole at 635'</u> <u>Lost hole at 635'</u> <u>25' C. Rigging up.</u>
<u>3/25</u>	<u>Drlg 200'</u>
<u>4/1</u>	<u>Done - offset.</u>
<u>4/7</u>	_____
<u>4/15</u>	<u>Drlg 500'</u>
<u>4/21</u>	<u>" 1150</u>
<u>4/29</u>	<u>1887 drilling, looks like they</u> <u>have missed Bartlesville (Tel)</u>
<u>5/5</u>	<u>J.D. 1955 missed Bkn sand.</u> <u>Top line 1900' S-a. 1955</u>

*Sherwood Co*

Map No. *K21* KANSAS Sec. *28* Twp. *22* R. *12*

Well No. *1* *Franchousser*

*Z. S. Simmons* Company

Contractor

FIRST REPORTS

SECTION PLAT

*360* Ft. from N. Line  
Ft. from S. Line  
*1120* Ft. from E. Line  
Ft. from W. Line

	0		

Location

Rig up

Drilling and Remarks:

**RECORD**  
 Cased \_\_\_\_\_ in., \_\_\_\_\_ ft.  
 Sand \_\_\_\_\_  
 Gas \_\_\_\_\_  
 Oil \_\_\_\_\_  
 Total Depth \_\_\_\_\_

**PRODUCTION**  
 1st 24 hrs. Nat. \_\_\_\_\_  
 1st 24 hrs. after shot \_\_\_\_\_  
 Gas \_\_\_\_\_ Cu. Ft.  
 Dry Hole \_\_\_\_\_  
 Abandoned \_\_\_\_\_

Date

JAN 20 1926

192 CHAS. L. SHERWOOD Scout

*Sherwood*

Map No. *K21* KANSAS Sec. *28* Twp. *22* R. *12*

Well No. *1* *Franchousser*

*Z. S. Simmons* Company

Contractor

COMPLETED

SECTION PLAT

*200* Ft. from N. Line  
Ft. from S. Line  
*1120* Ft. from E. Line  
Ft. from W. Line

	0		

ABANDONED *offset*

Location

Rig up

Drilling and Remarks:

*Missed to sand*  
*Tap line 1900'*  
*DW 1955'*  
*sh m*

**RECORD**  
 Cased \_\_\_\_\_ in., \_\_\_\_\_ ft.  
 Sand \_\_\_\_\_  
 Gas \_\_\_\_\_  
 Oil \_\_\_\_\_  
 Total Depth *1955*

**PRODUCTION**  
 1st 24 hrs. Nat. \_\_\_\_\_  
 1st 24 hrs. after shot \_\_\_\_\_  
 Gas \_\_\_\_\_ Cu. Ft.  
 Dry Hole   
 Abandoned

Date

MAY 5 1926

192 CHAS. L. SHERWOOD Scout