

Well No. 2 Clark Farm

Company

NORTH

WEST

EAST

SOUTH

Location _____

Drilling Remarks:

Rig Up

Drilling Remarks:

RECORD

Cased _____ in. _____ ft.

Sand _____

Gas _____

Oil_____

Total Depth_____

PRODUCTION

1st 24 hrs. Nat. _____

1st 24 hrs. after shot_____

Gas_____cu. ft.

Dry Hole _____

Abandoned _____

Map No. _____ Sec. 28 Twp. 22 R. 11

Well No. 2 Clark Farm
Gray Company
NORTH


NORTH

200 Ft. from N. Line

Ft. from S. Line

Ft. from E. Line

1120 Ft. from W. Line

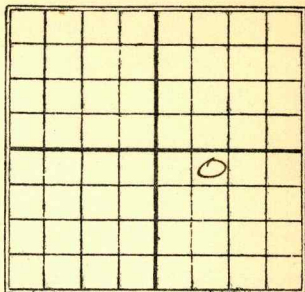

WEST

EAST

SOUTH

Date 1923

REPORT

2/6	Rig.
4/20	Sand 1963-72 - Shot 60 gts. 35 Bbls.

Map No. **KANSAS** Sec. 28 Twp. 22 R. 11Well No. 26Gray et al. Company

Contractor

COMPLETED SECTION PLAT200 Ft. from N. Line

Ft. from S. Line

Ft. from E. Line

1120 Ft. from W. Line

		0	

Location

Rig up

Drilling and Remarks:

1963-1972shot 69/35**RECORD**

Cased _____ in., _____ ft.

Sand _____

Gas _____

Oil _____

Total Depth _____

PRODUCTION

1st 24 hrs. Nat. _____

1st 24 hrs. after shot _____

Gas _____ Cu. Ft.

Dry Hole _____

Abandoned _____

Date

APR 20 1923

191

M. A. BENEAR

Scout

Map No. ²¹**KANSAS** Sec. **28** Twp. **22** R. **11**Well No. **2 Clark**
Gray Company
Contractor

FIRST REPORT

200 Ft. from N. Line

Ft. from S. Line

Ft. from E. Line

1120 Ft. from W. Line

SECTION PLAT

		6	

Location

Rig up ✓ ✓

Drilling and Remarks:

RECORD

Cased _____ in., _____ ft.

Sand _____

Gas _____

Oil _____

Total Depth _____

PRODUCTION

1st 24 hrs. Nat. _____

1st 24 hrs. after shot _____

Gas _____ Cu. Ft.

Dry Hole _____

Abandoned _____

Date

FEB 6 1923**M. A. BENEAR**

191

Scout