



Greenwood ✓

KANSAS

Sec. 28 Twp. 22 R. 11E

Well No. #1 Hess Farm

Pat Murphy

Company


Miscellaneous (Jackman & Jackman Contr.)

\_\_\_\_\_ Ft. from N. Line

360' \_\_\_\_\_ Ft. from S. Line

336' \_\_\_\_\_ Ft. from E. Line

\_\_\_\_\_ Ft. from W. Line

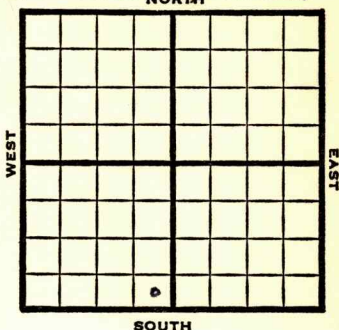

SE SW Twin Well

REPORT

1949

12/7

8" @ 61'  
5" @ 1960'  
Drlg. 1970'

12/14

"

12/21

"

12/28

"

1950

2/8

TD 1970'  
8"@ 61'  
5"@ 1960'  
Miss 1960'  
D&A  
Aband.

**ABANDONED**

Map No. \_\_\_\_\_ Sec. 28 Twp. 22 R. 11E

Well No. 1 Hess

Pat Murphy Company

Jackman & Jackman Contractor

SE SW

FIRST REPORT  
SECTION PLAT

\_\_\_\_\_ Ft. from N. Line

360 Ft. from S. Line

336 Ft. from E. Line

\_\_\_\_\_ Ft. from W. Line


Greenwood County

Location \_\_\_\_\_

Rig up \_\_\_\_\_

Drilling and Remarks:

twin well

8" @ 61

5" @ 1960

drlg. 1970

RECORD

Cased \_\_\_\_\_ in., \_\_\_\_\_ ft.

Sand \_\_\_\_\_

Gas \_\_\_\_\_

Oil \_\_\_\_\_

Total Depth \_\_\_\_\_

PRODUCTION

1st 24 hrs. Nat. \_\_\_\_\_

1st 24 hrs. after shot \_\_\_\_\_

Gas \_\_\_\_\_ Cu. Ft.

Dry Hole \_\_\_\_\_

Abandoned \_\_\_\_\_

Date

DEC 7 1949 19

S. J. LEWIS Scout

Kansas

Map No. \_\_\_\_\_ Sec. 28 Twp. 22 R. 11E

Well No. 1 Hess

Pat Murphy Company

\_\_\_\_\_ Contractor

SE SW

*E.I.*

SECTION PLAT

ABANDONED		

\_\_\_\_\_ Ft. from N. Line

360 Ft. from S. Line

336 Ft. from E. Line

\_\_\_\_\_ Ft. from W. Line

Greenwood County

RECORD

Location \_\_\_\_\_

Cased \_\_\_\_\_ in., \_\_\_\_\_ ft.

Rig up \_\_\_\_\_

Sand \_\_\_\_\_

Drilling and Remarks:

Gas \_\_\_\_\_

*8" @ 61*  
*5" @ 1960*  
*miss 1960*

Oil \_\_\_\_\_

Total Depth 1970

*D+A.*

PRODUCTION

1st 24 hrs. Nat. \_\_\_\_\_

1st 24 hrs. after shot \_\_\_\_\_

Gas \_\_\_\_\_ Cu. Ft.

Dry Hole \_\_\_\_\_

Abandoned \_\_\_\_\_

Date

FEB 8 1950 19

J. E. TYRA Scout