


Section 29 Township 22 Range 4E

Well No. #1 Adolph Goering

Company Beaumont Petr.

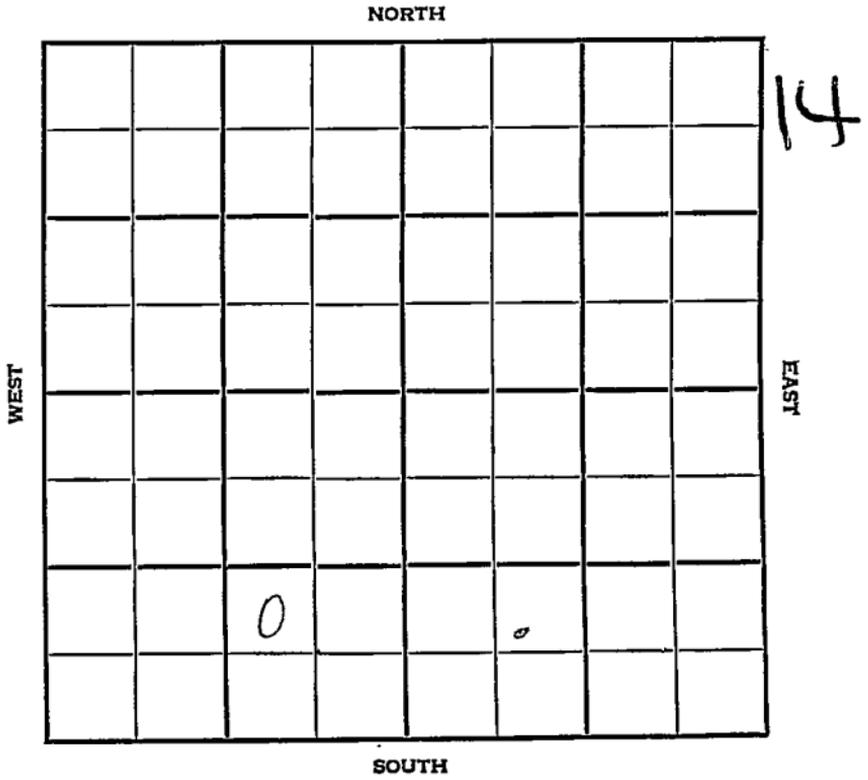

County Marion Elev. _____
 Sec. 29 Twp. 22 Rgs. 1E
 Company Beaumont Pet.
 Farm Name Adolph Goering No. I

TOPS	DEPTH	LOG	DATUM	Loc. in Sec.						
Anh.				NW SE SW						
TP.										
H.										
Tr.										
Dg.										
Bl.										
L.				Geol. _____						
K.C.				Contr. _____						
B.K.C.										
Ce.										
C.										
M.										
M.				Pool						
K.				<u>Edmonds</u>						
Mz.				<table border="1"> <tr> <td colspan="2">FIRST REPORT</td> </tr> <tr> <td>JAN 9 '57</td> <td></td> </tr> <tr> <td>0</td> <td></td> </tr> </table>	FIRST REPORT		JAN 9 '57		0	
FIRST REPORT										
JAN 9 '57										
0										
Me.										
V.										
S.										
S.										
A.										
R.										
PE.										
G.										
T.D.										

Date Comm. M I R

(Handwritten mark)

Co.
Lse.
No.
Sec.
T.
R.

Co.

County Marion Elev. 1241
 Sec. 29 Twp. 22 Rgs. LE
 Company Beaumont Pet.
 FarmName Adolph Coering No. 1

TOPS	DEPTH	LOG	DATUM	Loc. in Sec.
Anh.				NW SE S4
TP.				
H.				
Tr.				
Dg.				
BL.				
L.	1835			Geol.
K.C.				Contr.
B.K.C.	2235			
Ce.				
C.	Marm 2315			
M.	chert 2471			
M.	21 2480			Pool
K.				Edmonds
Mz.				
Mo.				
V.				
S.				
S.				
A.				
R.				
PE.				
G.				
TD.	2505			

L.S.

ABANDONED
 JAN 23 '57

No.

Date Comm.

Sec.

T.

R.

A. I R JAN 15 '57 1-8-57 85/8 @
 110 @ 2480 JAN 23 '57 DST 2470
 -80 45" 75' M & W BHP 620

DEA