


Section 29 Township 22 Range 5E

Well No. #1 Logan

Company Don Ingling

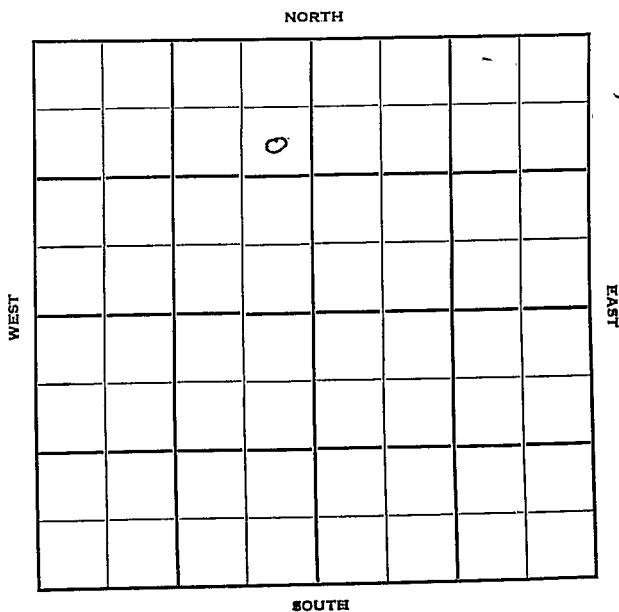

3

Marion

KANSAS

Sec. 29 Twp. 22 R. 5E

Well No. #1 Logan Farm

Don Ingling Company

Wildcat Contractor


990' Ft. from N. Line

Ft. from S. Line

330' Ft. from E. Line

Ft. from W. Line


SE NE NW

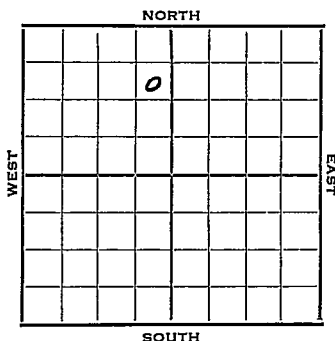

1952 Elev. 1474' REPORT

5/7 Location
5/28 Spud 5-9-52
D&A TD 2810' 8" @ 162'
Lans. 1803 KC 2046
Miss. 2412 KH. 2495
Misener 2598 Viola 2604
Simp. 2690 Arb. 2780
TD 2810 D&A

ABANDONED

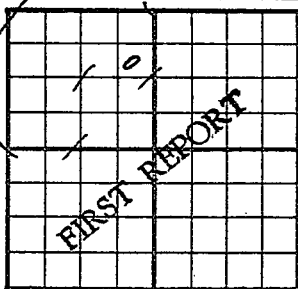County Marion State KansasSec. 29 (Blk. Twp.) 22 (Sur. Rge.) 5E Map No.Operator Don InglingWell No. 1 Farm LoganElev. Location SE NE NW990 Ft. From N Line NW350 Ft. From E Line Quarter1st. Report MAY 7 1952

Completion

Remarks

Spudding Date


Drlg. Data WildcatLocationJ. G. McGEHEE

County Marion State Kansas
 Sec. 29 (Blk.) 22 (Sur.) 5E Map No.
 (Twp.) (Rge.)

Operator Don Ingling

Well No. 1 Farm Logan

Elev. 1474 Location SE NE NW

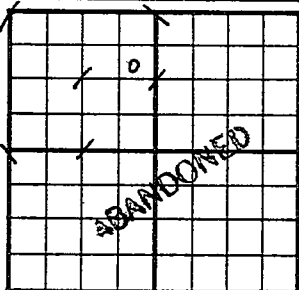

990 Ft. From N Line NW

330 Ft. From E Line Quarter

1st. Report

Completion MAY 28 1952

Remarks Wildcat

Spudding Date 5-9-52

Drlg. Data D & A TD 2810

8" @ 162 Lans. 1803 KC 2046

Miss. 2412 Kh. 2495 Misener 2598

Viola 2604 Simp. 2690 Arb. 2780

TD 2810

D & A