

KANSAS

Form 51—5M—11-38—Palace

Chase



Section 29 Township 22 Range 6-E

Well No. 1 Burns

Company Alex. McCoy et al


Wildcat

NORTH

WEST

EAST

SOUTH

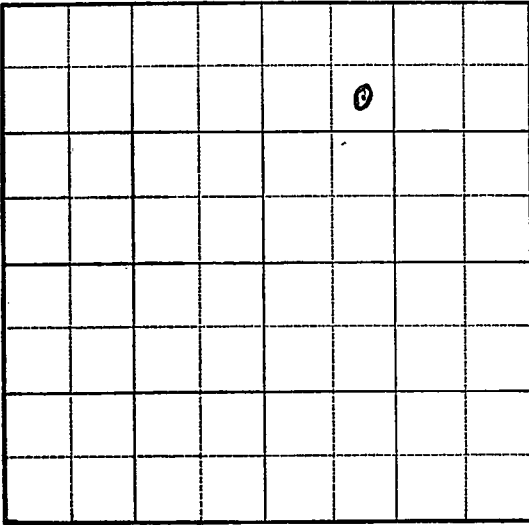

Map No. 23 Sec. 29 Twp. 22 R. 6EWell No. 1 BurnsAlex. McCoy et al

Company

Contractor

FIRST REPORT
SE NW NE

SECTION PLAT

		0	

990 Ft. from N. Line

Ft. from S. Line

Ft. from E. Line

990 Ft. from W. Line

WILDCAT

Location

Rig up

Drilling and Remarks:

15" - 150

Drig. 600

RECORD

Cased _____ in., _____ ft.

Sand _____

Gas _____

Oil _____

Total Depth _____

PRODUCTION

1st 24 hrs. Nat. _____

1st 24 hrs. after shot _____

Gas _____ Cu. Ft.

Dry Hole _____

Abandoned _____

Date

APR 26 1939

19

H. D. Hatfield Scout

Map No. 23 Sec. 29 Twp. 22 R. 6EWell No. 1 BurnsAlex McCoy etal

Company

Contractor

ABANDONED

SE NW NE

990 Ft. from N. Line Ft. from S. Line Ft. from E. Line990 Ft. from W. Line

SECTION PLAT

		o R	

WILDCAT

RECORD

Location Rig up

Drilling and Remarks:

*Core 3043**6" @ 3044**Water*Cased in., ft.Sand Gas Oil Total Depth 3065

PRODUCTION

1st 24 hrs. Nat. 1st 24 hrs. after shot Gas Cu. Ft.Dry Hole Abandoned

Date

JUN 7 1939 19

S. J. LEWIS

Scout