

HOT FILE Greenwood KANSAS

SEC. # 29	TWP. 22 S	R. 10 E
WELL NO. (Browning Unit Wtr. Flood)		
# 11 Browning Unit Tr. "F"		
COMPANY Sinclair (DEVELOPMENT-OBOC) FARM		
CONTRACTOR		


Browning Field.

2080 _____ FT. FROM N. LINE

_____ FT. FROM S. LINE

_____ FT. FROM E. LINE

830 _____ FT. FROM W. LINE

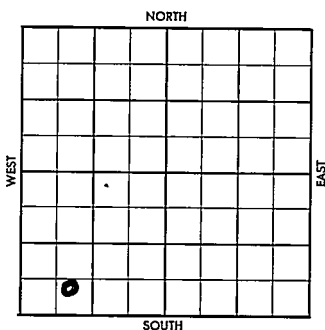

of SW/4 of Sec.

SE SW SW

1957	ELEVATION	REPORT
	2500'	Bartlesville Test <u>No FR</u>
4/8	Spudded 3-27-57 Drlg. 1493'	(DR#69-1957)
4/9	TD 1493'. NR	
4/10	Drlg. 2060'	
4/11	TD 2426'. WOC. 5 1/2" @ 2368'	
4-12	TD 2426' " "	
4-15	Drlg. 2426'. WOC. 5 1/2" csg.	
4-16	TD 2426'. Bailing	
4-17	Drlg. TD 2426' NR	
4/18	TD 2426'. Cleaning out.	
4/22	TD 2426'. Prep to acidize	
4/23	TD 2426'. No Oil test. Open Hole 2368-2426'. Bartlesville Zone. Complete	(DR#79-1957)

COMPLETED