


Map No. Kansas Sec. 29 Twp. 22 R. 10Well No. 3 Prather FarmTexas Co Company

NORTH

WEST

EAST

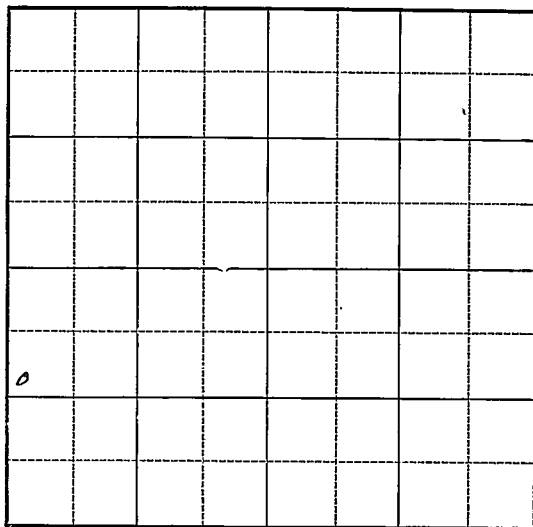

SOUTH

12

Location _____

Drilling Remarks _____

Rig Up _____

Drilling Remarks _____

RECORD

Cased _____ in. _____ ft.

Sand _____

Gas _____

Oil _____

Total Depth _____

PRODUCTION

1st 24 hrs. Nat. _____

1st 24 hrs. after shot _____

Gas _____ cu. ft.

Dry Hole _____

Abandoned _____


Greenwood Co
 Map No. Kansas Sec. 29 Twp. 22 R. 10
 Well No. 3 Prather Farm
Texas Co Company

NORTH

WEST

EAST

SOUTH

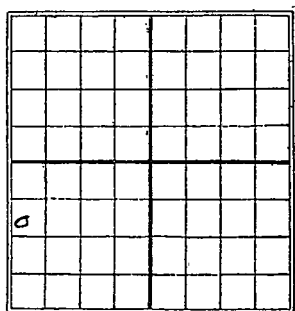

990 Ft. from N. Line

_____ Ft. from S. Line

_____ Ft. from E. Line

330 Ft. from W. Line

Date 1925

REPORT

11/27 Timbers

12/3 Rig

12/10 —

12/17 Rigging up

12/23 — 8 S. D.

12/31 Only 275'

1926

1/8 Only 840'

1/14 ✓ 1100'

1/20 ✓ 1535'

2/7 ✓ 1900'

2/14 ✓ 2410'

2/10 Sand 2406-2430
80 gts 180 Barrels

Greenwood Co
 Map No. *K21* KANSAS Sec. *29* Twp. *22* R. *10*
 Well No. *3* *Matheson*
Lex Co

Company

Contractor

SECTION PLAT

990 Ft. from N. Line

_____ Ft. from S. Line

_____ Ft. from E. Line

330 Ft. from W. Line

<i>0</i>			

FIRST REPORTS

Location _____

Rig up *Timmons*

Drilling and Remarks:

RECORD

Cased _____ in., _____ ft.

Sand _____

Gas _____

Oil _____

Total Depth _____

PRODUCTION

1st 24 hrs. Nat. _____

1st 24 hrs. after shot _____

Gas _____ Cu. Ft.

Dry Hole _____

Abandoned _____

Date

NOV 27 1925

CHAS. L. SHERWOOD

192

Scout

Sherwood Co
 K21 KANSAS Sec. 29 Twp. 32 R. 10
 Map No. 3 *Platton*
 Well No. _____
Lex Co Company Company

Contractor _____

COMPLETED

SECTION PLAT

990 Ft. from N. Line

_____ Ft. from S. Line

_____ Ft. from E. Line

330 Ft. from W. Line

Location _____

Rig up _____

Drilling and Remarks:

oil 2406'

89 180 bhs.

RECORD

Cased _____ in. _____ ft.

Sand 2406-2430'

Gas _____

Oil _____

Total Depth 2430'

* PRODUCTION

1st 24 hrs. Nat. _____

1st 24 hrs. after shot _____

Gas _____ Cu. Ft.

Dry Hole _____

Abandoned _____

Date

FEB 10 1926

192 CHAS. L. SHERWOOD
Scout