Form 51—5M—7-25—19788


Greenwood Co.

Map No. Kansas Sec. 29 Twp. 22 R. 10

Well No. 3 Prather Farm

C. W. Tatum Company

Ida Oil

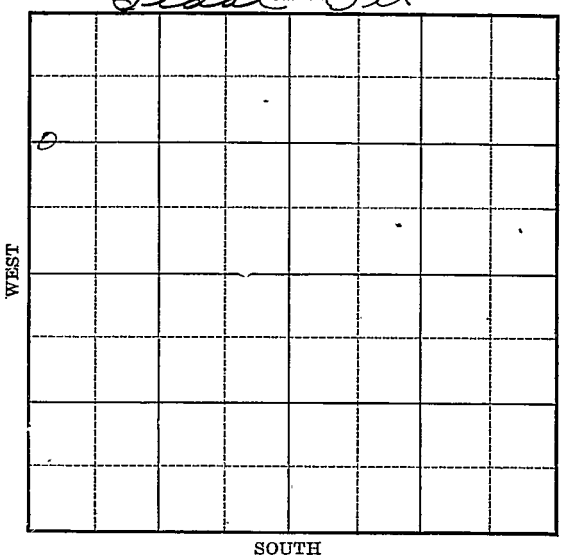

4

Location

Drilling Remarks

Rig Up

Drilling Remarks

RECORD

Cased in. ft.

Sand

Gas

Oil

Total Depth

PRODUCTION

1st 24 hrs. Nat.

1st 24 hrs. after shot

Gas cu. ft.

Dry Hole

Abandoned

Form 252A—5M—7-25—19684

Greenwood

Map No. KANSAS Sec. 29 Twp. 22 R 10

Well No. 3 Prather Farm

~~C. W. Titus~~ Company


Tidal Oil

1320 Ft. from N. Line

_____ Ft. from S. Line

_____ Ft. from E. Line

300' Ft. from W. Line

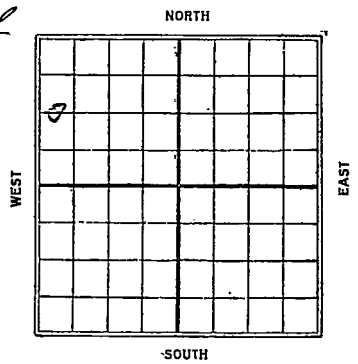

1926

Date	REPORT
3/24	Rig
3/3	
3/10	
3/18	
3/25	Rigging up
4/1	Dlg 500
4/7	" 850
4/15	" 1550
4/21	" 2410
4/29	Sd. 2431-2510-T.D. 180/400 BBls.

Form 26—1M Bks.—3-23—11959. Sherwood Co


Map No. K21 KANSAS Sec. 29 Twp. 22 R. 10

Well No. 3 Prather

C. A. Litus Company

Contractor

SECTION PLAT

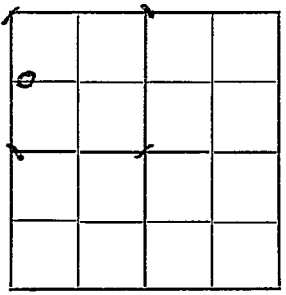

1320 Ft. from N. Line

Ft. from S. Line

Ft. from E. Line

360 Ft. from W. Line

FIRST REPORTS

Location ✓

Rig up

Drilling and Remarks:

RECORD

Cased in., ft.

Sand

Gas

Oil

Total Depth

PRODUCTION

1st 24 hrs. Nat.

1st 24 hrs. after shot

Gas Cu. Ft.

Dry Hole

Abandoned

Date

FEB 24 1926

192

CHAS. L. SHERWOOD

Scout

Form 26—1M Bks.—3-23—11959. J. Koenwood

K21 KANSAS Sec. 29 Twp. 22 R. 10

Well No. 3 Norton

Tidal Oil Co Company

Contractor

COMPLETED


1320 Ft. from N. Line

Ft. from S. Line

Ft. from E. Line

300 Ft. from W. Line

SECTION PLAT

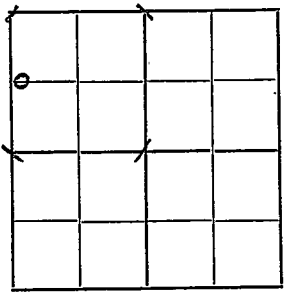

Location

Rig up

Drilling and Remarks:

1894 00 BS.

RECORD

Cased in., ft.

Sand 2431- 2510

Gas

Oil

Total Depth 2510

PRODUCTION

1st 24 hrs. Nat.

1st 24 hrs. after shot

Gas Cu. Ft.

Dry Hole

Abandoned

Date

APR 28 1926

192 CHAS. L. SHERWOOD Scout