


SEC. 1 TWP. R.  
 29 22 S 10 E

WELL NO. # 2A-W Browning Unit (Waterflood) ARM  
 COMPANY

CONTRACTOR Sinclair (Development--OBOC)

760 \_\_\_\_\_ Ft. from N. Line  
 \_\_\_\_\_ Ft. from S. Line  
 \_\_\_\_\_ Ft. from E. Line  
 330 \_\_\_\_\_ Ft. from W. Line

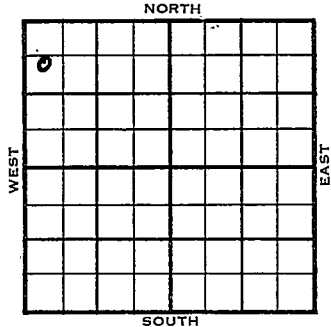

of NW/4  
 SW NW NW

	ELEVATION	REPORT
--	-----------	--------

1955

11/3	Spud 10-27-55 Drlg. 1760'	<u>No FR</u> (DR #216)
11/4	Drlg. 2118'	
11/7	TD 2400'. Coring.	
11/8	TD 2400'. No report.	
11/9	TD 2499'. Coring.	
11/10	TD 2499'. WOC - 5½" @ 2364'	
11/11	TD 2499' Drilling plug.	
11/14	TD 2499'. Cleaned out	
11/15	TD 2499' Cleaned out	
11/16	TD 2499' Open hole 2364-299', Bartlesville Zone. <u>Water Injection well.</u>	

ABANDONED