


HOT FILE

Greenwood KANSAS

SEC.	TWP.	R.
29	22 S	10 E
WELL NO. (Browning Unit Waterflood)		
# 28 Browning Unit "C" FARM		
COMPANY		
Sinclair O & G (DEVELOPMENT-OBOC)		
CONTRACTOR		

1320 _____ Ft. from N. Line
 _____ Ft. from S. Line
 380 _____ Ft. from E. Line
 _____ Ft. from W. Line

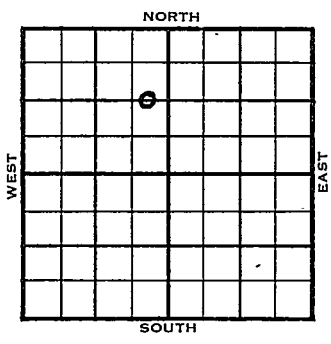

of NW/4
 E/2 E/2 NW

ELEVATION	REPORT
-----------	--------

1956	Projected Bartlesville Sand @ 2500'
1/3	WORT. TD 95' <i>No FR</i> (DR#256)
1/4	TD 95'. No report.
1/5	TD 95'. WORT
1/6	TD 95'. No report.
1/9	TD 95'. WORT
1/10	TD 95'. No report.
1/11	Drlg. 1525'
1/12	TD 2260'. Prep to core.
1/13	TD 2344'. Coring.
1/16	TD 2471'. Rng 5 1/2" csg.
1/17	TD 2471'. WOC - 5 1/2" @ 2323'
1/18	TD 2471'. Drlg. plug.
1/19	TD 2471'. No report.
1/20	TD 2471'. Bailing.
1/23	TD 2471'. Prepare to frac.
1/24	TD 2471'. No report.
1/25	TD 2471'. Bailing.
1/26	TD 2471'. Pumping load oil
1/27	TD 2471'. Drlg. plug.
1/30	TD 2471'. Swabbed 5 BO 24 hrs, open hole 2303-2320', Bartlesville Zone COMPLETE

COMPLETED