

# HOT FILE Greenwood KANSAS

SEC. 29 TWP. 22 S R. 10 E


WELL NO. (Browning Wtr. Flood)  
# 29-W Browning Unit "C" FARM

COMPANY Sinclair (DEVELOPMENT-OBOC)

CONTRACTOR

## Browning Field.

\_\_\_\_\_ FT. FROM N. LINE  
 270 \_\_\_\_\_ FT. FROM S. LINE  
 830 \_\_\_\_\_ FT. FROM E. LINE  
 \_\_\_\_\_ FT. FROM W. LINE

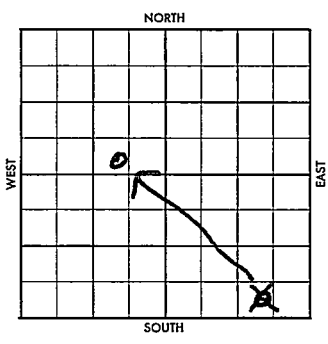

of ~~Sec 4~~ <sup>NW/4</sup>  
 SW SE ~~SE~~ <sup>NW</sup>

1957	ELEVATION	REPORT
	2450'	Bartlesville Test <span style="float: right;"><u>No FR</u></span>
1/2	MIRT	<span style="float: right;">1957</span>
1/3	Spudded 12-28-56	<span style="float: right;">(DR#1)</span>
1/4	Drlg. 1900'	
1/7	TD 1900' NR	
1/8	Coring @ 2358'	
1/9	TD 2375'. WOC - 5 1/2" @ 2335'	
1/10	TD 2375'. WOC - 5 1/2" csg.	
1/11	TD 2375' " "	
1/14	" " "	
1/15	WD 2375'. Bailing.	
1/16	TD 2375'. Drlg. plug.	
1/17	(Corrected location: 270' FSL & 830' FEL, of NW/4)	(DR#11)
1/17	TD 2375'	Shut down motor trouble.
1/18	" "	"
1/21	TD 2375'	No report.
1/22	TD 2375'	Repairing motor.
1/23	" "	"
1/24	TD <del>27</del> 2375'	Drilling plug.
1/25	TD 2375'	CO
1/28	TD 2375'	Prep to set pkr.
1/29	TD 2375'	NR

OVER

1957  
1/30

TD 2375' Water Injection Well.  
Open hole 2335-2375' Bartlesville  
Zone. Complete (DR#21-1957)

**COMPLETED**