

Map No. Kansas Sec. 29 Twp. 22 R. 10Well No. 2 Prather FarmTexas Company

NORTH

WEST

EAST

SOUTH

12

Location _____

Drilling Remarks _____

Rig Up _____

Drilling Remarks _____

RECORD

Cased _____ in. _____ ft.

Sand _____

Gas _____

Oil _____

Total Depth _____

PRODUCTION

1st 24 hrs. Nat. _____

1st 24 hrs. after shot _____

Gas _____ cu. ft.

Dry Hole _____

Abandoned _____

Map No. KANSAS Sec. 29 Twp. 22 R. 10
 Well No. 2 Prather Farm
Texas Co Company


250' Ft. from N. Line

_____ Ft. from S. Line

_____ Ft. from E. Line

760' Ft. from W. Line

1925

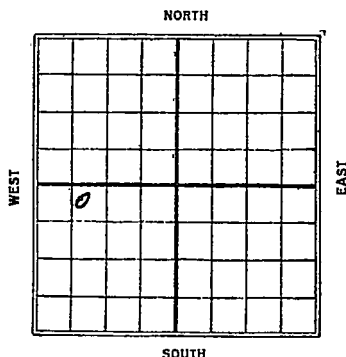

Date

REPORT

10/16	Limbers
10/22	_____
10/29	Rig
11/6	Rig'n up
11/13	175
11/19	960'
11/27	1200'
12/3	810 1950'
12/10	810 2080'
12/11	J. S. 2488-2526' will shoot 80 gts
12/23	Fishing pipe
12/31	_____
1926	_____
1/8	_____
1/14	_____
1/20	Land 2488-2526 80 gts 125 Bbls

Moenwood Co

K21 Map No. KANSAS Sec. 29 Twp. 22 R. 10

Well No. 2 Mather

Ley Co

Company

Contractor

FIRST REPORTS

SECTION PLAT

250

Ft. from N. Line

Ft. from S. Line

Ft. from E. Line

760

Ft. from W. Line

0			

Location

Rig up Lembers

Drilling and Remarks:

RECORD

Cased _____ in., _____ ft.

Sand _____

Gas _____

Oil _____

Total Depth _____

PRODUCTION

1st 24 hrs. Nat. _____

1st 24 hrs. after shot _____

Gas _____ Cu. Ft.

Dry Hole _____

Abandoned _____

Date

OCT 16 1925

192

CHAS. L. SHERWOOD

Scout

K21 **KANSAS** *29* *22* *10*
 Map No. _____ Sec. _____ Twp. _____ R. _____
 Well No. *2* *1/2* *1/2* *1/2*
Lex Co *Company*
 _____ Company
 _____ Contractor

COMPLETED

SECTION PLAT

250

Ft. from N. Line

Ft. from S. Line

Ft. from E. Line

760

Ft. from W. Line

Location _____

Rig up _____

Drilling and Remarks:

801/125 bks.

RECORD

Cased _____ in. _____ ft.

Sand *2488-2526*

Gas _____

Oil _____

Total Depth *2526*

PRODUCTION

1st 24 hrs. Nat. _____

1st 24 hrs. after shot _____

Gas _____ Cu. Ft.

Dry Hole _____

Abandoned _____

Date

JAN 20 1926

192

CHAS. L. SHERWOOD

Scout