
Form 51—5M—7-25—1978

Map No. Kansas Sec. 29 Twp. 22 R. 10 Greenwood

Well No. 6 Prather Farm

Texas Co Company

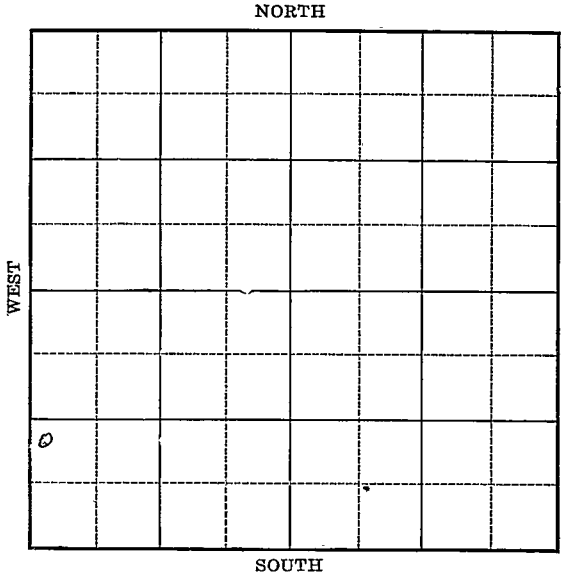

13


Location	Rig Up
Drilling Remarks	Drilling Remarks
RECORD	PRODUCTION
Cased in. ft.	1st 24 hrs. Nat.
Sand	1st 24 hrs. after shot
Gas	Gas cu. ft.
Oil	Dry Hole
Total Depth	Abandoned

Form 252A—5M—7-25—19684

Map No. Kansas Sec. 29 Twp. 22 R. 10

Well No. 6 Prather Farm

Texas Company Company

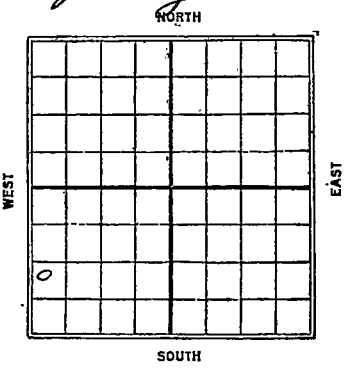

_____ Ft. from N. Line

990 Ft. from S. Line

_____ Ft. from E. Line

330 Ft. from W. Line

Date 1926	REPORT
3/25	Timbers
4/7	—
4/15	Rigging
4/21	Spudding
4/30	Dlg 800'
5/8	" 1200'
5/12	" 1500'
5/19	Sand 2403-2445' I.D. 120/170 BBls.

Form 26—1M Bks.—3-23—11959. B Sherwood

K21
Map No. KANSAS Sec. 29 Twp. 22 R. 10

Well No. 6 Prather

Lexa Company Company

Contractor

FIRST REPORTS


Ft. from N. Line

990 Ft. from S. Line

Ft. from E. Line

330 Ft. from W. Line

SECTION PLAT

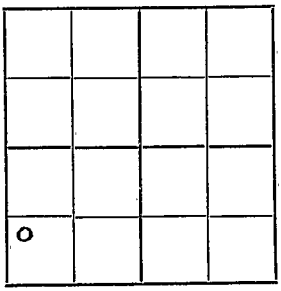

Location

Rig up Timbers

Drilling and Remarks:

RECORD

Cased in., ft.

Sand

Gas

Oil

Total Depth

PRODUCTION

1st 24 hrs. Nat.

1st 24 hrs. after shot

Gas Cu. Ft.

Dry Hole

Abandoned

Date

MAR 25 1926

192

CHAS. L. SHERWOOD

Scout

Form 26—1M Bks.—3-23—11959. Sherwood

K21 KANSAS Map No. Sec. 29 Twp. 22 R. 10

Well No. 6 Frazier

Texas Company Company

Contractor

COMPLETED


Ft. from N. Line

990 Ft. from S. Line

Ft. from E. Line

330 Ft. from W. Line

SECTION PLAT

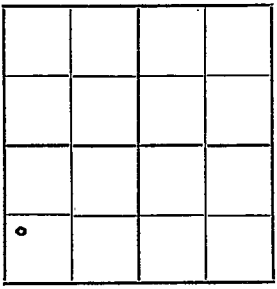

Location

Rig up

Drilling and Remarks:

120/170 lbs.

RECORD

Cased in., ft.

Sand 2403-2445

Gas

Oil

Total Depth 2445'

PRODUCTION

1st 24 hrs. Nat.

1st 24 hrs. after shot

Gas Cu. Ft.

Dry Hole

Abandoned

Date

MAY 19 1926

192

CHAS. L. SHERWOOD

Scout