


Map No. Kansas Sec. 29 Twp. 22 R. 10
 Well No. 8 Prather Farm
Texas Company Company

NORTH

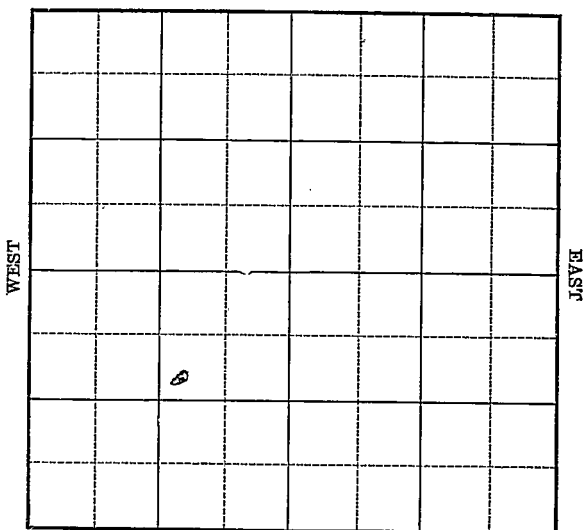

SOUTH

Location _____

Drilling Remarks _____

Rig Up _____

Drilling Remarks _____

RECORD

Cased _____ in. _____ ft.

Sand _____

Gas _____

Oil _____

Total Depth _____

PRODUCTION

1st 24 hrs. Nat. _____

1st 24 hrs. after shot _____

Gas _____ cu. ft.

Dry Hole _____


Abandoned _____

990 Ft. from N. Line

Ft. from S. Line

990 Ft. from E. Line

Ft. from W. Line

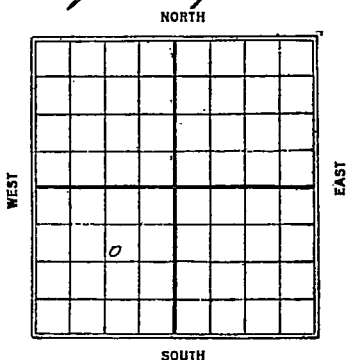

Date /

REPORT

3/25	Timbers
------	---------

4/7/ —

4/14	
------	--

12/1	
4/21	

121	
146	

730	—
1	2

5/8	Same.
-----	-------

5/14	Layne
------	-------

5/19 Dlg 13 70'

6/2 Sand 2360-2381

7	T.D. 2404 80 ats
---	------------------

	50 lbs
--	--------

K21
 Map No. KANSAS Sec. 29 Twp. 22 R. 10
 Well No. 8 Prather
Leys Company Company

Contractor

FIRST REPORTS

SECTION PLAT

990 Ft. from N. Line

_____ Ft. from S. Line

990 Ft. from E. Line

_____ Ft. from W. Line

	o		

Location _____

Rig up Leys

Drilling and Remarks:

RECORD

Cased _____ in., _____ ft.

Sand _____

Gas _____

Oil _____

Total Depth _____

PRODUCTION

1st 24 hrs. Nat. _____

1st 24 hrs. after shot _____

Gas _____ Cu. Ft.

Dry Hole _____

Abandoned _____

Date

MAR 25 1926

192

CHAS. L. SHERWOOD

Scout

Shenwood
 K21 KANSAS Sec. 29 Twp. 22 R. 10
 Map No. 8 *Platten*
 Well No. *Lex & Company* Company
 Contractor

COMPLETED

SECTION PLAT

990 Ft. from N. Line

Ft. from S. Line

990 Ft. from E. Line

Ft. from W. Line

	0		

Location

Rig up

Drilling and Remarks:

8450 lbs.

RECORD

Cased in. ft.

Sand 2360-2381

Gas

Oil

Total Depth 2404

PRODUCTION

1st 24 hrs. Nat.

1st 24 hrs. after shot

Gas Cu. Ft.

Dry Hole

Abandoned

Date

JUN 2 1926

CHAS. L. SHERWOOD
 192 Scout