
Form 51—5M—7-25—1978

Kansas Greenwood

Map No. 10 Sec. 29 Twp. 22 R. 10

Well No. 1 Prather Farm

Titus et al Company

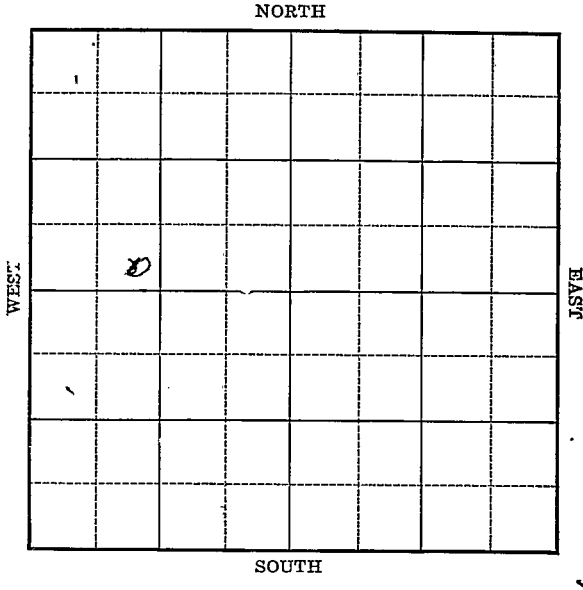


5

Location

Drilling Remarks

Rig Up

Drilling Remarks

RECORD

Cased in. ft.

Sand

Gas

Oil

Total Depth

PRODUCTION

1st 24 hrs. Nat.

1st 24 hrs. after shot

Gas cu. ft.

Dry Hole

Abandoned


Form 252A—5M—7-25—19684

Greenwood

Map No. Kansas Sec. 29 Twp. 22 R 10 ✓

Well No. 10 Prather Farm

Titus etal Company

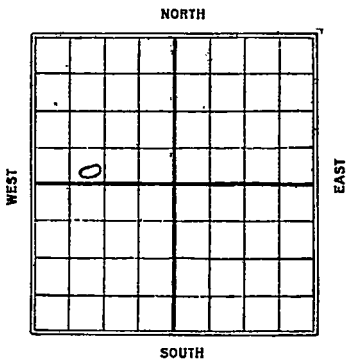


Ft. from N. Line

250 Ft. from S. Line

Ft. from E. Line

760 Ft. from W. Line

| Date 1925 | REPORT |
|---|---|
| 11/6 | Timbers |
| 11/12 | — |
| 11/19 | Rig |
| 11-27 | — |
| 12/3 | Running 8" 1000' |
| 12/10 | Drlg 1550' |
| 12/17 | Drlg 1600' |
| 12/23 | Drlg 1850' |
| 12/31 | Drlg 2375' |
| 1926 | |
| 1/8 | Sand 2382-2432 140 gts |
| | 150 Bbls |

Form 26—1M Bks.—3-23—11959. Sherwood Co

Map No. KANSAS Sec. 29 Twp. 22 R. 10

Well No. 7 Mathers

Titus et al Company

Contractor

## FIRST REPORTS


Ft. from N. Line

750 Ft. from S. Line

Ft. from E. Line

760 Ft. from W. Line

## SECTION PLAT

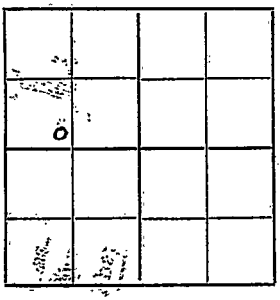

Location

Rig up Jim Rogers.

Drilling and Remarks:

## RECORD

Cased in., ft.

Sand

Gas

Oil

Total Depth

## PRODUCTION

1st 24 hrs. Nat.

1st 24 hrs. after shot

Gas Cu. Ft.

Dry Hole

Abandoned

Date

NOV 6 1925

192

CHAS. L. SHERWOOD

Scout

Form 26—1M Bks.—3-23—11959. Sherwood Co.

21 Map No. KANSAS Sec. 29 Twp. 22 R. 10

Well No. 1 Prather

Zitus et al Company

Contractor

COMPLETED


Ft. from N. Line

2520 Ft. from S. Line

Ft. from E. Line

760 Ft. from W. Line

SECTION PLAT

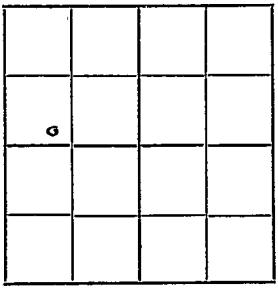

Location

Rig up

Drilling and Remarks:

140/150 bbls.

RECORD

Cased in., ft.

Sand 2382-2432'

Gas

Oil

Total Depth 2432'

PRODUCTION

1st 24 hrs. Nat.

1st 24 hrs. after shot

Gas Cu. Ft.

Dry Hole

Abandoned

Date

JAN 8 1926 192

CHAS. L. SHERWOOD Scout

Form 26—1M Bks.—3-23—11959. Sherwood Co

K21 KANSAS Map No. Sec. 29 Twp. 22 R. 10

Well No. 10 Pla Khon

C. M. Titus Company

Contractor

## CORRECTION


Ft. from N. Line

350 Ft. from S. Line

Ft. from E. Line

760 Ft. from W. Line

SECTION PLAT

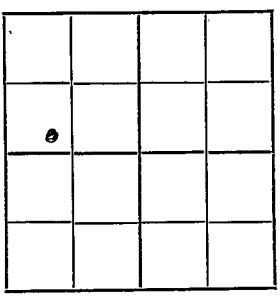

Location

Rig up

Drilling and Remarks:

1 Hay 150 #5

Chg Roll Number

to above. Location

reported as #7.

## RECORD

Cased in., ft.

Sand 2382- 2432'

Gas

Oil

Total Depth 2432'

## PRODUCTION

1st 24 hrs. Nat.

1st 24 hrs. after shot

Gas Cu. Ft.

Dry Hole

Abandoned

Date

FEB 24 1926 192

CHAS. L. SHERWOOD Scout