


Map No. Kans Sec. 29 Twp. 22 R. V10EWell No. 11 * Prather FarmTitus et al Company

NORTH

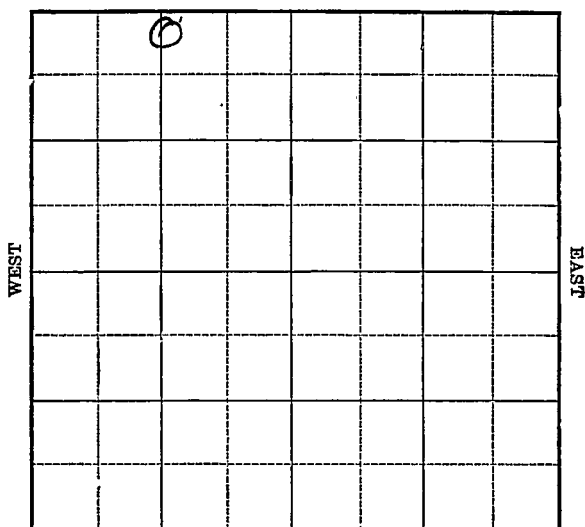

SOUTH

3

Location _____

Drilling Remarks

working on these

Rig Up _____

Drilling Remarks

RECORD

Cased _____ in. _____ ft.

Sand _____

Gas _____

Oil _____

Total Depth _____

PRODUCTION

1st 24 hrs. Nat. _____

1st. 24 hrs. after shot _____

Gas _____ cu. ft.


Dry Hole _____

Abandoned _____

Map No. Kaw Sec. 29 Twp. 22 R. 10 ✓Well No. 11 * Prather FarmTitus et al Company300 Ft. from N. Line

Ft. from S. Line

Ft. from E. Line

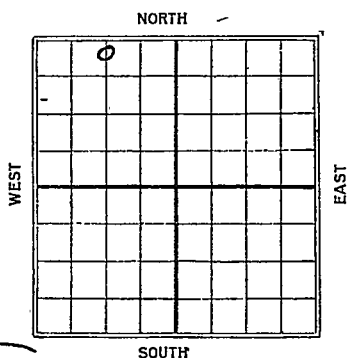1320 Ft. from W. Line

Date

REPORT

19257/31 Loc8/17 Rig8/14 Rig in8/198/26 1220'9/3 1600'9/11 2110'9/16 —9/249/25 2399-2466 T.D. 2467100 gts 350 Bbls

Map No. North Sec. 29 Twp. 22 R. 10
 Well No. 4 Rock theer
Littus & al Company

Contractor

FIRST REPORTS

SECTION PLAT

	0		

300 Ft. from N. Line

_____ Ft. from S. Line

_____ Ft. from E. Line

1320 Ft. from W. Line

Location ☒

Rig up _____

Drilling and Remarks: _____

RECORD

Cased _____ in., _____ ft.

Sand _____

Gas _____

Oil _____

Total-Depth _____

PRODUCTION

1st 24 hrs. Nat. _____

1st 24 hrs. after shot _____

Gas _____ Cu. Ft.

Dry Hole _____

Abandoned _____

Date

JUL 31 1925

CHAS. L. SHERWOOD

Scout

Sherwood Co

Map No. KANSAS Sec. 29 Twp. 22 R. 10
 Well No. 4 Prather
Titus of #1 Company

Contractor

COMPLETED

SECTION PLAT

360

Ft. from N. Line

Ft. from S. Line

Ft. from E. Line

1320

Ft. from W. Line

Location

Rig up

Drilling and Remarks:

RECORD

Cased in., 11 ft.Sand 7399-2466'

Gas

Oil

Total Depth 2467'

PRODUCTION

1st 24 hrs. Nat.

1st 24 hrs. after shot

Gas Cu. Ft.

Dry Hole

Abandoned

Date

SEP 25 1925.

192

CHAS. L. SHERWOOD

Scout

Greenwood Co
 Map No. *K21* KANSAS Sec. *29* Twp. *22* R. *10*
 Well No. *11* *North*
Q. H. Titus Company

Contractor

CORRECTION

330 Ft. from N. Line

Ft. from S. Line

Ft. from E. Line

1320 Ft. from W. Line

SECTION PLAT

Change from #4 to ~~##~~ #11

Location

Rig up

Drilling and Remarks:

1061 350 BS

*Chg well number
to above. Previous
Reported as #4*

RECORD

Cased _____ in., _____ ft.

Sand *2299-2466*

Gas _____

Oil _____

Total Depth *2467*

PRODUCTION

1st 24 hrs. Nat. _____

1st 24 hrs. after shot _____

Gas _____ Cu. Ft.

Dry Hole _____

Abandoned _____

Date

FEB 24 1926

CHAS. L. SHERWOOD

192

Scout