


Map No. Kansas Sec. 29 Twp. 22 R. 10 *Greenwood*

Well No. 14 Prather Farm

C.W. Titus Company

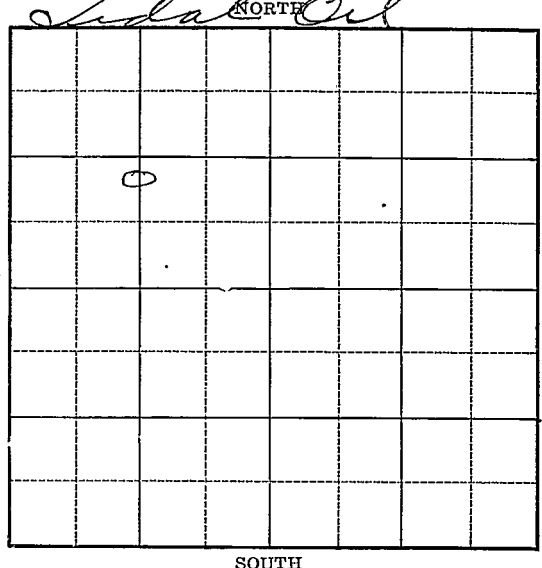

Location _____

Drilling Remarks _____

Rig Up _____

Drilling Remarks _____

RECORD

Cased _____ in. _____ ft.

Sand _____

Gas _____

Oil _____

Total Depth _____

PRODUCTION

1st 24 hrs. Nat. _____

1st 24 hrs. after shot _____

Gas _____ cu. ft.

Dry Hole _____

Abandoned _____

Sherwood Co

K21 Map No. **KANSAS** Sec. *29* Twp. *22* R. *10*


Well No. *14* *Platton*

Q. H. Titus

Company

Contractor

SECTION PLAT

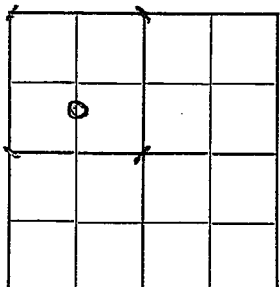

_____ Ft. from N. Line

800

_____ Ft. from S. Line

_____ Ft. from E. Line

1320

_____ Ft. from W. Line

FIRST REPORTS

Location _____

Rig up _____

Drilling and Remarks:

RECORD

Cased _____ in., _____ ft.

Sand _____

Gas _____

Oil _____

Total Depth _____

PRODUCTION

1st 24 hrs. Nat. _____

1st 24 hrs. after shot. _____

Gas _____ Cu. Ft.

Dry Hole _____

Abandoned _____

Date

FEB 24 1926

CHAS. L. SHERWOOD

192

Scout

Sherwood

K21 KANSAS Sec. *29* Twp. *22* R. *10*
Map No. -----

Well No. *14* *Artoth*
Zed ad Co Company

Contractor

COMPLETED

SECTION PLAT

----- Ft. from N. Line
800
----- Ft. from S. Line
----- Ft. from E. Line
1320
----- Ft. from W. Line

	o		

Location -----
Rig up -----
Drilling and Remarks:

100/200 SS.

RECORD

Cased ----- in., ----- ft.
Sand *2351-2405*
Gas -----
Oil -----
Total Depth *2405*

PRODUCTION

1st 24 hrs. Nat. -----
1st 24 hrs. after shot -----
Gas ----- Cu. Ft.
Dry Hole -----
Abandoned -----

Date
APR 28 1926

192 **CHAS. L. SHERWOOD**
Scout