


Kansas Greenwood
Map No. _____ Sec. 29 Twp. 22 R. 10
Well No. 16 & Prather Farm
Titus et al Company

NORTH

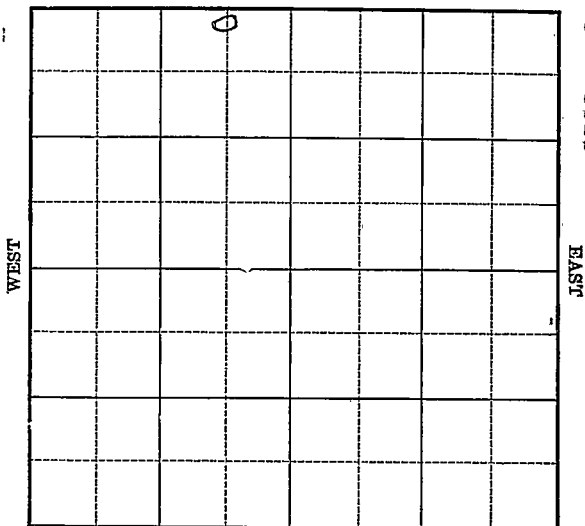

SOUTH

3

Location _____

Drilling Remarks

Rig Up _____

Drilling Remarks

RECORD

Cased _____ in. _____ ft.

Sand _____

Gas _____

Oil _____

Total Depth _____

PRODUCTION

1st 24 hrs. Nat. _____

1st 24 hrs. after shot _____

Gas _____ cu. ft.

Dry Hole _____

Abandoned _____

Sherwood Co

Map No. **KANSAS** Sp. *29* Twp. *22* R. *10*

Well No. *6* *Prather*

Litus & D Company

Contractor

FIRST REPORTS

SECTION PLAT

750 Ft. from N. Line

_____ Ft. from S. Line

820 Ft. from E. Line

_____ Ft. from W. Line

	o		

Location _____

Rig up

Drilling and Remarks:

RECORD

Cased _____ in., _____ ft.

Sand _____

Gas _____

Oil _____

Total Depth _____

PRODUCTION

1st 24 hrs. Nat. _____

1st 24 hrs. after shot _____

Gas _____ Cu. Ft.

Dry Hole _____

Abandoned _____

Date

OCT 1 1925
192

CHAS. L. SHERWOOD
Scout

Sherwood Co

Map No. *K21* KANSAS Sec. *29* Twp. *22* R. *10*

Well No. *6* *MARKER*

Jones et al Company

Contractor

COMPLETED

SECTION PLAT

250 Ft. from N. Line

_____ Ft. from S. Line

820 Ft. from E. Line

_____ Ft. from W. Line

	0'		

Location _____

Rig up _____

Drilling and Remarks:

1609 150 lbs

RECORD

Cased _____ in., _____ ft.

Sand *2264-2327*

Gas _____

Oil _____

Total Depth *2327*

PRODUCTION

1st 24 hrs. Nat. _____

1st 24 hrs. after shot _____

Gas _____ Cu. Ft.

Dry Hole _____

Abandoned _____

Date NOV 6 1925

CHAS. L. SHERWOOD

192 Scout

Sherwood Co

K21 Map No. KANSAS Sec. 29 Twp. 22 R. 10

Well No. 16 11a 11011
C. H. Lites Company

Contractor

CORRECTION

SECTION PLAT

330 Ft. from N. Line
Ft. from S. Line
820 Ft. from E. Line
Ft. from W. Line

	0		

Change from # 6 to # 16

Location -----

Rig up -----

Drilling and Remarks:

164 150 85

Chq well number
to show. previous
reported as #6.

RECORD

Cased 1 in. ft.
Sand 2264-2327
Gas -----
Oil -----
Total Depth 2327

PRODUCTION

1st 24 hrs. Nat. -----
1st 24 hrs. after shot -----
Gas ----- Cu. Ft.
Dry Hole -----
Abandoned -----

Date

FEB 24 1926

CHAS. L. SHERWOOD

192 Scout