Form 51—5M—7-25—19786


Greenwood Jo

Map No. Kansas Sec. 3 Twp. 22 R. 10

Well No. 1 Pixley (Pixlee) Farm

Tidal & ~~Mission~~ Company A. R. Jones

NORTH

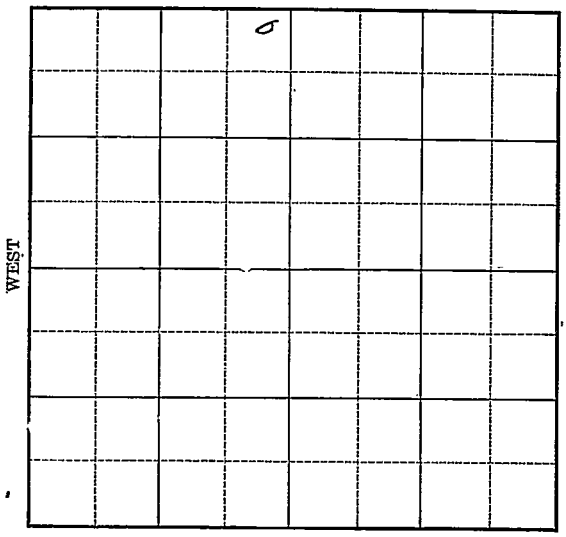

Location	Rig Up
Drilling Remarks	Drilling Remarks

RECORD		PRODUCTION	
Cased	in. ft.	1st 24 hrs. Nat.	
Sand		1st 24 hrs. after shot	
Gas		Gas	cu. ft.
Oil		Dry Hole	
Total Depth		Abandoned	

Form 252A—5M—7-25—19684

Greenwood

Map No. Kansas Sec. 3 Twp. 22 R 10

Well No. 1 Pucley Farm

Tidal & ~~Marion~~ Company


H. R. J. Hayes

330 Ft. from N. Line

Ft. from S. Line

330 Ft. from E. Line

Ft. from W. Line

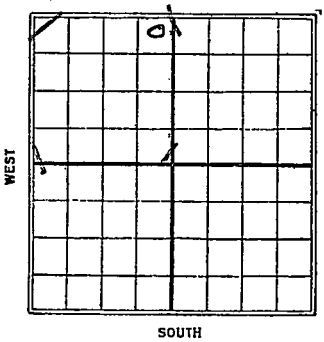

Date 1925	REPORT
12/23	Bldg Rig
12/31	~~Spudding (chg ownership)~~ ~~T.D. 22 32 2057' swabbed 70 bbls 1st 24 hrs, 80 bbls 2nd 24 hrs, 50 bbls 3rd 24 hrs, mill drill depth.~~
12/31 1926	Spudding (chg ownership)
1/8	Drlg 735'
1/14	" 1040'
1/20	" 1410
1/29	" 1700'
2/4	Top lime 2163' Dlg 2178'
2/10	" " " small show oil 2185-2195 TD 2206' 700' water in hole S.D.
2/17	——
2/24	——
3/3	——
3/10	——
3/18	Abandoned 2206

Form 26—1M Bks.—3-23—11959. Sherwood Co

Map No. KANSAS Sec. 21 3 Twp. 22 R. 10

Well No. 1 Tinsley

Lidal & Mission Company

Contractor

330 Ft. from N. Line


Ft. from S. Line

330 Ft. from E. Line

Ft. from W. Line

FIRST REPORTS

SECTION PLAT

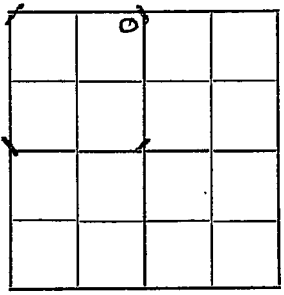

Location

Rig up

Drilling and Remarks:

Blow Rig

RECORD

Cased in., ft.

Sand

Gas

Oil

Total Depth

PRODUCTION

1st 24 hrs. Nat.

1st 24 hrs. after shot

Gas Cu. Ft.

Dry Hole

Abandoned

Date

DEC 2 3 1925

192

CHAS. L. SHERWOOD

Scout

Form 26—1M Bks.—3-23—11959. Sherwood & Co.


Map No. 21 KANSAS Sec. 13 Twp. 23 R. 10

Well No. 1 Tuckey

Lidell & W. B. Jones Company

Contractor

SECTION PLAT

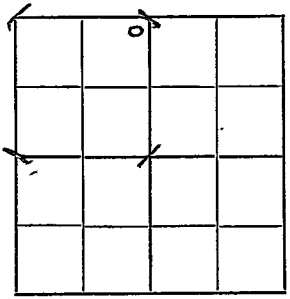

3320 Ft. from N. Line

Ft. from S. Line

3320 Ft. from E. Line

Ft. from W. Line

CORRECTION

Location

Rig up

Drilling and Remarks:

Spudding

Ship ownership

to above

RECORD

Cased in., ft.

Sand

Gas

Oil

Total Depth

PRODUCTION

1st 24 hrs. Nat.

1st 24 hrs. after shot

Gas Cu. Ft.

Dry Hole

Abandoned

Date

DEC 3 1 1925

192

CHAS. L. SHERWOOD

Scout

Form 26—1M Bks.—3-23—11959. Greenwood

1621 KANSAS Map No. Sec. 3 Twp. 22 R. 10

Well No. 1 Pixley

Lidell & A. B. Jones Company

Contractor

COMPLETED

330 Ft. from N. Line


Ft. from S. Line

330 Ft. from E. Line

Ft. from W. Line

ABANDONED

SECTION PLAT

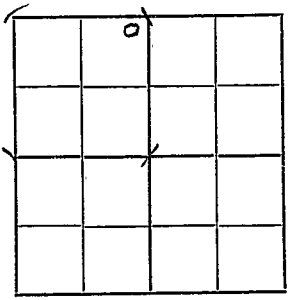

Location

Rig up

Drilling and Remarks:

Top Lime 2163'
Small show oil
2185-2195'
Dry & Abd
TD 2206'

RECORD

Cased in., ft.

Sand

Gas

Oil

Total Depth 2206'

PRODUCTION

1st 24 hrs. Nat.

1st 24 hrs. after shot

Gas Cu. Ft.

Dry Hole ✓

Abandoned

Date

MAR 18 1926 192

CHAS. L. SHERWOOD Scout