


Map No. **KANSAS** Sec. **3** Twp. **22** R. **10**
 Well No. **2-Pixlee** Farm
Shelly Oil et al Company

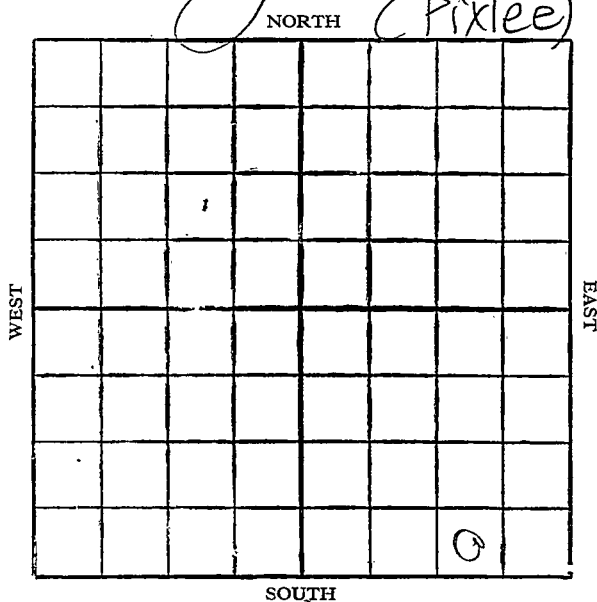

Location

Drilling Remarks

Rig Up.....

Drilling Remarks

RECORD

Cased in. ft.

Sand

Gas

Oil

Total Depth

PRODUCTION

1st 24 hrs. Nat.

1st 24 hrs. after shot

Gas cu. ft.

Dry Hole

Abandoned


Map No. _____ Sec. 3 Twp. 22 R. 10Well No. 2 - Riley Farm
Skelly Oil Co et al Company

_____ Ft. from N. Line

330 Ft. from S. Line990 Ft. from E. Line

_____ Ft. from W. Line

NORTH

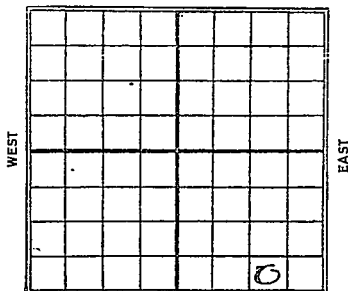

SOUTH

1928

Date

REPORT

Date	REPORT
2/1	Location
2/9	Rig
2/16	Drill 425
2/23	" 1175
3/1	" 1630
3/8	Land 2144-88 - T.D. 2196 - filled up 400' natural shot 180 qts - Cleaning out -
3/15	2144-2188 T.D. 2191 180/ 210 bbls

Sherwood

21 KANSAS Map No. _____ Sec. 3 Twp. 22 R. 10

Well No. 2 *Fisher* _____

Skelley Oil Co et al _____ Company

_____ Contractor

FIRST REPORTS

SECTION PLAT

			0

_____ Ft. from N. Line

330 _____ Ft. from S. Line

990 _____ Ft. from E. Line

_____ Ft. from W. Line

Location ☒ _____
Rig up _____
Drilling and Remarks: _____

RECORD

Cased _____ in., _____ ft.
Sand _____
Gas _____
Oil _____
Total Depth _____

PRODUCTION

1st 24 hrs. Nat. _____
1st 24 hrs. after shot _____
Gas _____ Cu. Ft.
Dry Hole _____
Abandoned _____

Date

FEB 1 1928

CHAS. L. SHERWOOD

_____ 192 _____ Scout

Sherwood
 21 KANSAS Sec. 3 Twp. 22 R. 10
 Map No. _____
 Well No. *2 fix line*
Kelly Oil Co Company
 Contractor

COMPLETED

SECTION PLAT

			0

_____ Ft. from N. Line

330 _____ Ft. from S. Line*990* _____ Ft. from E. Line

_____ Ft. from W. Line

Location _____

Rig up _____

Drilling and Remarks:

1807 no logs

RECORD

Cased _____ in., _____ ft.
 Sand *2144-2188*
 Gas _____
 Oil _____
 Total Depth *2191*

PRODUCTION

1st 24 hrs. Nat. _____
 1st 24 hrs. after shot _____
 Gas _____ Cu. Ft.
 Dry Hole _____
 Abandoned _____

Date

MAR 15 1928 CHAS. L. SHERWOOD
 192 Scout