

Section 3 Township 22 Range 12 E

Well No. # 1 Gasche

Company K. E. Wilson

NORTH

0							

13

WEST

EAST

SOUTH

Sec. 3 Twp. 22 R. 12 E

Well No. # 1 Gasche Farm

K. E. Wilson Company

Contractor


Ft. from N. Line

330 Ft. from S. Line

Ft. from E. Line

330 Ft. from W. Line

SW SW SW

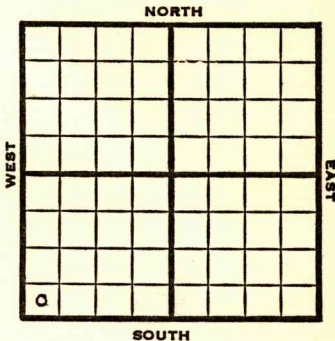

1951

Elev.-

REPORT

6/27

8" @ 65'

Bart 1811'

RTD 1820'

5" @ 1808'

7/25

D&A TD 1822

8" @ 65'

Bart 1811 5" @ 1808

TD 1822 30 qt/1808-20 D&A

ABANDONED

