


Greenwood
Map No. KANSAS Sec. 30 Twp. 22 R. 11^E
Well No. 10 Swens Farm
F. A. Gardner et al Company

NORTH

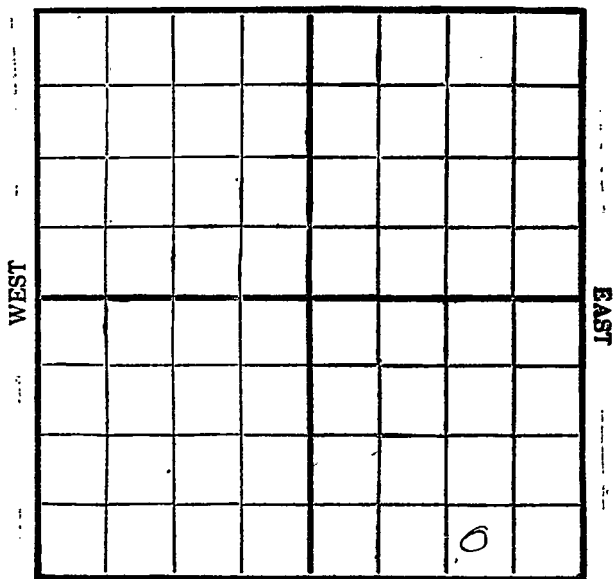

SOUTH

Location _____
Drilling Remarks _____

Rig Up _____
Drilling Remarks _____

RECORD

PRODUCTION

Cased _____ in. _____ ft.
Sand _____
Gas _____
Oil _____
Total Depth _____

1st 24 hrs. Nat. _____
1st 24 hrs. after shot _____
Gas _____ cu. ft. _____
Dry Hole _____
Abandoned _____

Map No. **KANSAS** Sec. 30 Twp. 22 R. 11^E


Well No. 1-9 Livens Farm
F.A. Gordon et al company

_____ Ft. from N. Line

330 Ft. from S. Line

990 Ft. from E. Line

_____ Ft. from W. Line

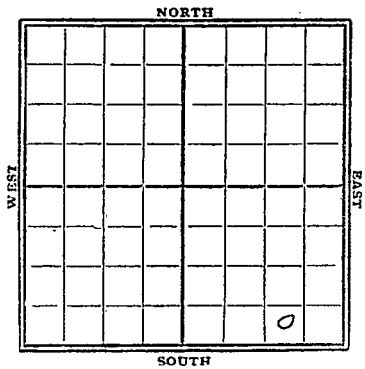

1929

Date	REPORT
7/31	Location
8/7	—
8/14	—
8/21	—
8/28	—
9/14	Spdy
9/11	Wrlg 510'
9/18	" 0 1240'
9/25	Top line 1965
	T.D. 2010' water SD
10/2	Top line 1965'
	T.D. 2010'
	Wry & Abandoned

Greenwood

K 21

Map No. **KANSAS** Sec. *3* Twp. *22* R. *11^E*

Well No. *1* *Sivens*

F. A. Gordon Coal Company

Contractor

FIRST REPORTS

SECTION PLAT

_____ Ft. from N. Line
330 Ft. from S. Line
990 Ft. from E. Line
 _____ Ft. from W. Line

			0

Location

Rig up _____

Drilling and Remarks:

RECORD

Cased _____ in., _____ ft.

Sand _____

Gas _____

Oil _____

Total Depth _____

PRODUCTION

1st 24 hrs. Nat. _____

1st 24 hrs. after shot _____

Gas _____ Cu. Ft.

Dry Hole: _____

Abandoned _____

Date
JUL 3 1 1929

CHAS. L. SHERWOOD

Sherwood

Map No. 21 **KANSAS** Sec. 3 Twp. 22 R. 11

Well No. 1 *Siemens*

F. A. Gordon & Co Company

Contractor

SECTION PLAT

COMPLETE

			0

_____ Ft. from N. Line

330 Ft. from S. Line

990 Ft. from E. Line

_____ Ft. from W. Line

ABANDONED

Location _____

Rig up _____

Drilling and Remarks:

Top line 1965

RECORD

Cased _____ in., _____ ft.

Sand _____

Gas _____

Oil _____

Total Depth 7010'

PRODUCTION

1st 24 hrs. Nat. _____

1st 24 hrs. after shot _____

Gas _____ Cu. Ft.

Dry Hole

Abandoned

Date

OCT 2 1929

CHAS. L. SHERWOOD
Scout