

SEC. 30 TWP. R. 10 E

WELL NO. (Browning Unit Wtr. Flod # 5-W Browning Unit Tr. "G" FARM

COMPANY Sinclair (DEVELOPMENT-OB0C)

CONTRACTOR

Browning Field.


330 FT. FROM N. LINE

FT. FROM S. LINE

FT. FROM E. LINE

330 FT. FROM W. LINE

of E/2 SE/4 of Sec.

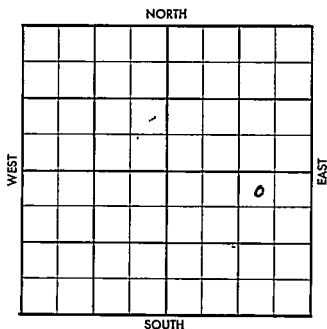

1957

ELEVATION

REPORT

2600' Bartlesville Test

No TR

9/6

Spudded 9-4-57
Reaming @ 207'

(DR#174)

9/9

TD 208'. WOC. 8-5/8" @ 206'

9/10

Drlg. 1818'

9/11

Drlg. 2183'

9/12

TD 2183'. NR

9/13

" "

9/16

TD 2499'. WOC. 5 1/2" @ 2474'

9/17

TD 2499'. WOC. 5 1/2" csg.

9/18

" " "

9/19

TD 2499'. Bailing.

9/20

TD 2499'. Drlg. plug.

9/23

TD 2499'. Pulling tbg.

9/24

TD 2499' NR

9/25

TD 2499' Water Injection Well
Open hole 2474-2499' Bartlesville
Zone. Complete (DR#187)

COMPLETED