

(TWH7-DC8) ✓

Greenwood

KANSAS

SECTION 30 TOWNSHIP 22S RANGE 10E

WELL NO. #4-Emma

COMPANY Gross Drlg.

NW NW NW

NORTH

WEST

EAST

0							

SOUTH

4

HOT FILE Greenwood **KANSAS**


SEC. 30 TWP. 22 S R. 10 E

WELL NO. ~~#1#1~~ Emma FARM

COMPANY Gross Drlg.
~~Gross Producing Co.~~

CONTRACTOR H & C Drlg.
Browning

_____ FT. FROM N. LINE
_____ FT. FROM S. LINE
_____ FT. FROM E. LINE
_____ FT. FROM W. LINE

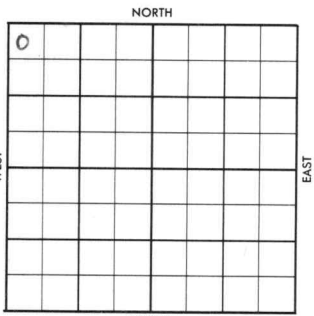

NW NW NW

SDX-DHC-#1330.00 (Lse S-8324 A&B-Chase County)

1957 ELEVATION 1645' DF REPORT (TWH7-DC8) ✓

7/9 Bartlesville Sand Test appx 2500'
To be commenced by August 1, 1957
To be completed by September 1, 1957
(See DHC Agrt 7-9-57)

7/24 Location (FR Tkt)

8/2 Drlg. 1231' (Report-Gross Drlg.)

8/6 Drlg. 2320' "

8/7 Drlg. 2500' "
Expect Sand about 2540-50' "

8/28 Spud 8-2-57
8-5/8" @ 201
5 1/2" @ 2600'
Perf60/2562-82, SO
Swbd 86.35 BO + 31.86 BW in 1 1/2 hrs.
nat. P/25 BOPD + wtr.
TD 2601' Barl. 2557'

COMPLETED

10/10 (Advised Contract Section- Oil Well) ✓

JUL 25 1957
M.M.

FORM 513 SUNRAY

County Greenwood Elev. _____

Sec. 30 Twp. 22 Rge. 10E

Company Gross Drlg.

Farm Name Emma No. 4

Co.

Lse.

No.

Sec.

T.

R.

TOPS	DEPTH	LOG	DATUM
Anh.			
Tr.			
H.			
Tr.			
Dg.			
Bl.			
L.			
K.C.			
B.K.C.			
Ce.			
C.			
M.			
M.			
K.			
Mz.			
Me.			
V.			
S.			
S.			
A.			
R.			
P.C.			
G.			
T.D.			

Loc. in Sec. NW NW NW

Geol. _____

Contr. H & C Drlg.

Pool Browning

0		
FIRST REPORT		
JUL 24 '57		

Date Comm. SDX - DHM

Location _____

~~Q~~

