


Greenwood **KANSAS**

SECTION 30 TOWNSHIP 22S RANGE 10E

WELL NO. #5 Emma

COMPANY Gross Prod.

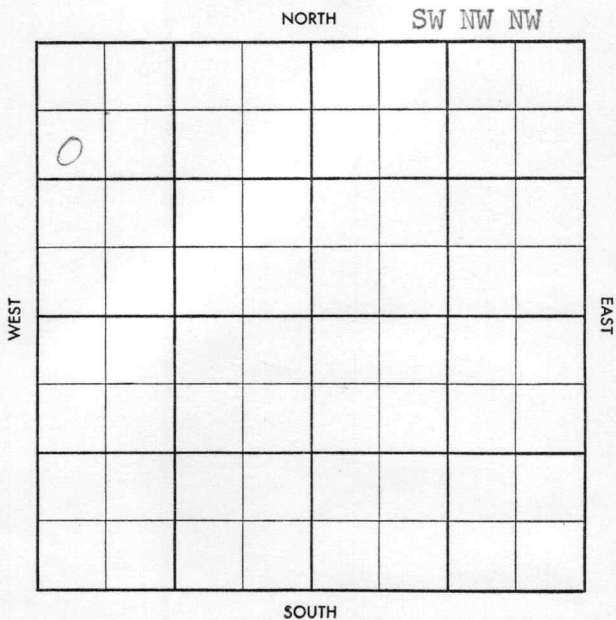

4

CO. Greenwood ELEV. _____

SEC. 30 TWP. 22 RGE. 10E

COMPANY Gross Prod. NO. 5

CO. _____
NOV 13 '57
COMPLETE

FARM Emma

LOC. SW NW NW

log

<u>Bar 2550</u>
<u>TD 2605</u>

GEOL. _____

CONTR. H & C

POOL Browning

SPUD 10-1-57

Location _____

UGT 23 '57

8" 200

LTD 2603 5 1/2 2605

112/2554-82

\$11 Bo pd not

25 Bo pd trw

Bar 2554-82

CO.

LSE.

NO.

SEC.

TWP.

RGE.