


Greenwood

KANSAS

SECTION 30 TOWNSHIP 22S RANGE 10E

WELL NO. #9 Emma

COMPANY Gross Prod. Co.

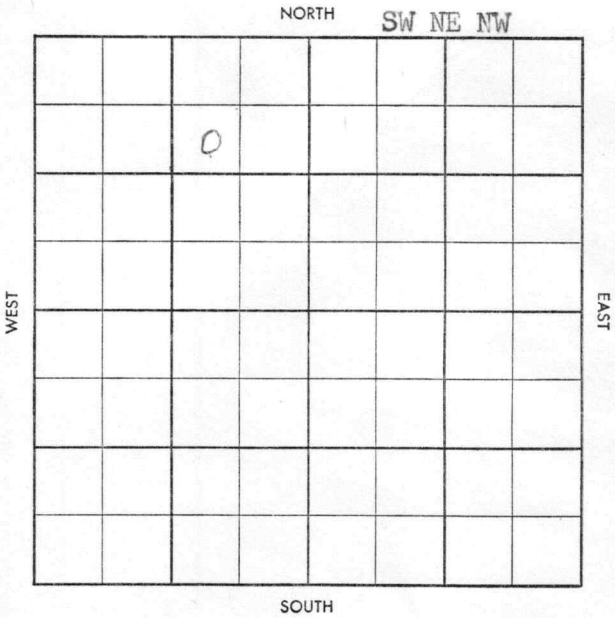

3

~~Tw~~ ~~Pool~~ ~~Drilling~~
~~Co~~ ~~Facet~~

S-513-B

County Greenwood Elev. _____
 Sec. 30 Twp. 22 Rge. 10E
 Company Gross Prod. Co.
 Farm Name Emma No. 9

TOPS	DEPTH	LOG	DATUM
Anh.			
Tp.			
H.			
Tr.			
Dg.			
B.L.			
L.			
K.C.			
B.K.C.			
Ce.			
C.			
M.			
M.			
K.			
Mz.			
Mq.			
V.			
S.			
S.			
A.			
R.			
Pf.			
G.			
T.D.			

Loc. in Sec. _____
SW NE NW
 Geol. _____
 Contr. _____
H & C Tools
 Pool _____
Seeley-Wick

FIRST REPORT
 JUN 11 1958

Date Comm. _____
WORT

Co.
 Lse.
 No.
 Sec.
 T.
 R.

Twp. ~~X~~ Pool ~~X~~ Barrowings
 Co. ~~X~~ Factor
 CORRECTION

5-513-B

County Greenwood Elev. MA
 Sec. 30 Twp. 22 Rge. 10E ~~11E~~
 Company Gross Prod. Co.
 Farm Name Emma No. 9

TOPS	DEPTH	LOG	DATUM
Anh.			
Tp.			
H.			
Tr.			
Dg.			
B.L.			
L. <u>Bar</u>	<u>2494</u>		
K.C.			
B.K.C.			
Ce.			
C.			
M.			
M.			
K.			
Mz.			
Mq.			
V.			
S.			
S.			
A.			
R.			
Pf.			
G.			
T.D.	<u>2569</u>		

Loc. in Sec. SW NE NW

Geol. _____
 Contr. H & C Tools

Pool Seeley-Wick



Date Comm. 6-18-58 8''175
 WORT JUN 18 '58 JUN 25 '58 wd 2505-50
fuller grad 5 1/2 2569
 WORT JUL 2 '58 JUL 9 '58 CO 2562
32/2522-30 frac 20,000 sd
tstg JUL 16 '58 \$80130 + 60BW
72hrs pop P 25130 pd +
200 Bwp

✍