


Map No. \_\_\_\_\_ Sec. 30 Twp. 22 R. 10  
Well No. 1 Household Farm \_\_\_\_\_  
Phillips Pet Company \_\_\_\_\_

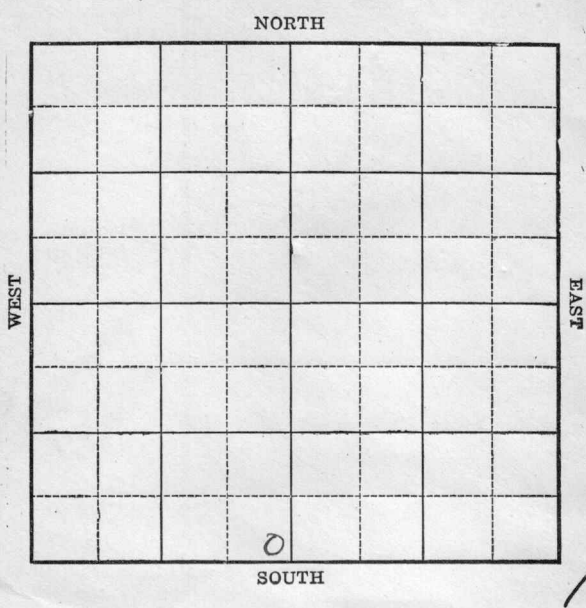

Location \_\_\_\_\_

Drilling Remarks:  
\_\_\_\_\_  
\_\_\_\_\_  
Rig up \_\_\_\_\_

Drilling Remarks:  
\_\_\_\_\_  
\_\_\_\_\_  
**RECORD**

Cased \_\_\_\_\_ in. \_\_\_\_\_ ft.  
Sand \_\_\_\_\_  
Gas \_\_\_\_\_  
Oil \_\_\_\_\_  
Total Depth \_\_\_\_\_

**PRODUCTION**

1st 24 hrs Nat. \_\_\_\_\_  
1st 24 hrs. after shot \_\_\_\_\_  
Gas \_\_\_\_\_ cu. ft.  
Dry Hole \_\_\_\_\_  
Abandoned \_\_\_\_\_



Map No. **KANSAS** 21 Sec. 3 Twp. 22 R. 10

Well No. 1 *Hausfelder*

*Phillips Pet* Company

Contractor

**FIRST REPORT**

**SECTION PLAT**

----- Ft. from N. Line

*244'*

----- Ft. from S. Line

*200'*

----- Ft. from E. Line

----- Ft. from W. Line


Location -----

Rig up -----

Drilling and Remarks:

*Timbers*

**RECORD**

Cased ----- in., ----- ft.

Sand -----

Gas -----

Oil -----

Total Depth -----

**PRODUCTION**

1st 24 hrs. Nat. -----

1st 24 hrs. after shot -----

Gas ----- Cu. Ft.

Dry Hole -----

Abandoned -----

Date

MAR 22 1923

192

M. A. BENEAR

Scout

Map No. *Kans* Sec. *30* Twp. *22* R. *10*

Well No. *1* *Householder*

*Phillips Pet* Company

Contractor

*Completed*

SECTION PLAT


----- Ft. from N. Line

*200* Ft. from S. Line

*200* Ft. from E. Line

----- Ft. from W. Line

RECORD

Location -----

Cased ----- in., ----- ft.

Rig up -----

Sand -----

Drilling and Remarks:

Gas -----

*Sand 2492-2544*

Oil -----

*120/130 fls*

Total Depth -----

PRODUCTION

1st 24 hrs. Nat. -----

1st 24 hrs. after shot -----

Gas ----- Cu. Ft.

Dry Hole -----

Abandoned -----

Date

*7/4 1923* *MB*

Scout