


Map No. 75 Sec. 30 Twp. 22 R. 10
 Well No. 3 Prather Farm
Mad Kansas Company

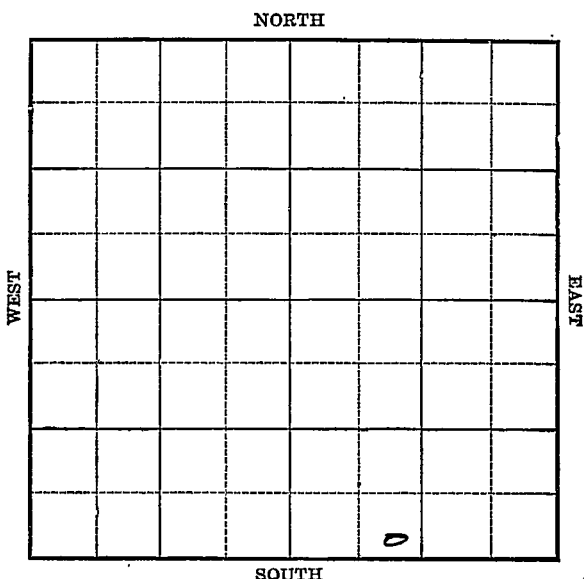

Location _____

Drilling Remarks:

Rig up _____

Drilling Remarks:

RECORD

Cased _____ in. _____ ft.

Sand _____

Gas _____

Oil _____

Total Depth _____

PRODUCTION

1st 24 hrs Nat. _____

1st 24 hrs. after shot _____

Gas _____ cu. ft.

Dry Hole _____

Abandoned _____


Map No. K Sec. 30 Twp. 22 R. 10
 Well No. 3 Prather Farm
Mad. Hans Company

 Ft. from N. Line

200 Ft. from S. Line

 Ft. from E. Line

1170 Ft. from W. Line

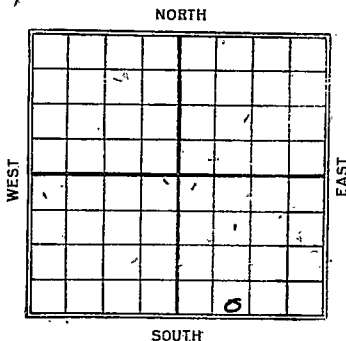

REPORT

Date

1924
6/10
7/16

Reg

Sand 2479-95

20/100 bbls.

Map No. 2/KANSAS Sec. 30 Twp. 22 R. 10
 Well No. 3 Prather
Mid Kans Company

Contractor

FIRST REPORT

SECTION PLAT

_____ Ft. from N. Line
200 Ft. from S. Line
 _____ Ft. from E. Line
1120 Ft. from W. Line

Location _____
 Rig up _____
 Drilling and Remarks:
Rig

RECORD

Cased _____ in., _____ ft.
 Sand _____
 Gas _____
 Oil _____
 Total Depth _____

PRODUCTION

1st 24 hrs. Nat. _____
 1st 24 hrs. after shot _____
 Gas _____ Cu. Ft.
 Dry Hole _____
 Abandoned _____

Date Nov 10 1924
192 M. A. BENEAR Scout

Map No. Kans³ Sec. 30 Twp. 22 R. 10Well No. 3 PratherMid-Kansas Company

Contractor

COMPLETED

_____ Ft. from N. Line

200' Ft. from S. Line

_____ Ft. from E. Line

1120' Ft. from W. Line**SECTION PLAT**

			6

Location _____

Rig up _____

Drilling and Remarks:

S. 2479-2495. 2020/100**RECORD**

Cased _____ in., _____ ft.

Sand _____

Gas _____

Oil _____

Total Depth _____

PRODUCTION

1st 24 hrs. Nat. _____

1st 24 hrs. after shot _____

Gas _____ Cu. Ft.

Dry Hole _____

Abandoned _____

Date

M.B. 7/23/24 Scout