


Map No. K Sec. 30 Twp. 22 R. 10

Well No. 2 - Prather Farm

Mid. Kansas Company

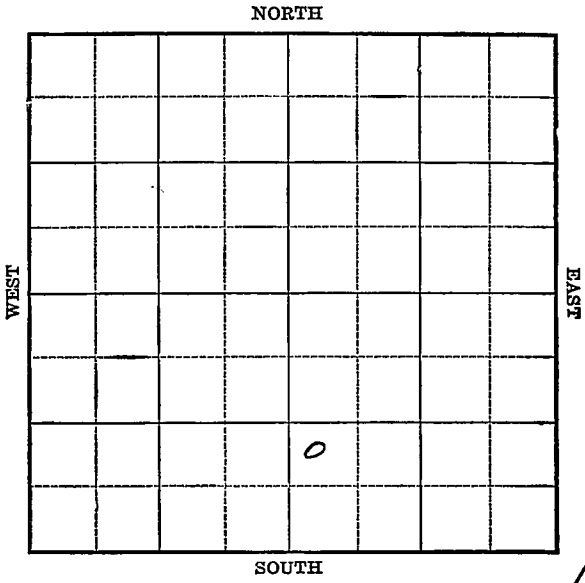

Location _____

Rig Up _____

Drilling Remarks:

Drilling Remarks:

RECORD

PRODUCTION

Cased _____ in. _____ ft.

1st 24 hrs. Nat. _____

Sand _____

1st 24 hrs. after shot _____

Gas _____

Gas _____ cu. ft.

Oil _____

Dry Hole _____

Total Depth _____

Abandoned _____

Map No. K Sec. 30 Twp. 22 R. 10

Well No. 2 Prather Farm


Mid-Kansas Company

_____ Ft. from N. Line

990 Ft. from S. Line

_____ Ft. from E. Line

330 Ft. from W. Line

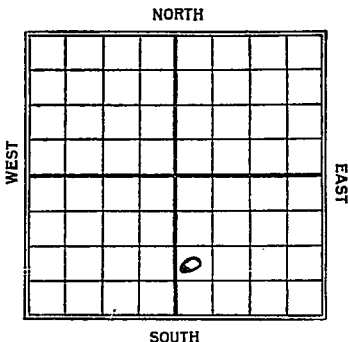

Date

REPORT

1924
2/27

Location
2448 Top of sand
2530-2578-
Top. 2580'
607 40 Blk on pump

Map No. **KANSAS** Sec. 30 Twp. 22 R. 10

Well No. 2 - Prather

Mid-Kansas Company

Contractor

FIRST REPORT

SECTION PLAT

_____ Ft. from N. Line

990 Ft. from S. Line

_____ Ft. from E. Line

330 Ft. from W. Line

		6	

Location ✓✓

Rig up _____

Drilling and Remarks:

RECORD

Cased _____ in., _____ ft.

Sand _____

Gas _____

Oil _____

Total Depth _____

PRODUCTION

1st 24 hrs. Nat. _____

1st 24 hrs. after shot _____

Gas _____ Cu. Ft.

Dry Hole _____

Abandoned _____

Date

FEB 27 1924

M. A. BENEAK

Scout

Map No. KANSAS 31 Sec. 30 Twp. 22 R. 10

Well No. # 2 Rather

Mid-Kansas Company

Contractor

COMPLETED SECTION PLAT

_____ Ft. from N. Line

990' Ft. from S. Line

_____ Ft. from E. Line

330' Ft. from W. Line

		0	

Location _____

Rig up _____

Drilling and Remarks:

Top sand 2448'

Pay 2550-2578'

T.D. 2580'

*shot 60 yds
pump jacking to this*

RECORD

Cased _____ in., _____ ft.

Sand _____

Gas _____

Oil _____

Total Depth _____

PRODUCTION

1st 24 hrs. Nat. _____

1st 24 hrs. after shot _____

Gas _____ Cu. Ft.

Dry Hole _____

Abandoned _____

Date APR 21 1924

M. A. BENEAR