

Map No. _____ Sec. 30 Twp. 22 R. 10

Well No. 3 Prather Farm _____


Phillips Company _____

_____ Ft. from N. Line

200 Ft. from S. Line

1120 Ft. from E. Line

_____ Ft. from W. Line

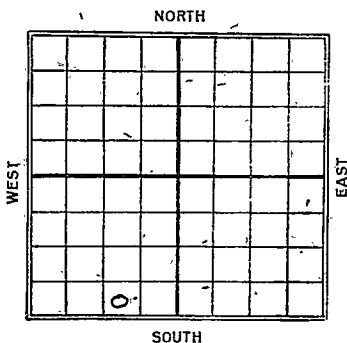

Date 1924

REPORT

8/6 2553 - 2610 T.D. 2612'
P.B. 2591' 80 gts 15 Bbls

Map No. 11 Sec. 30 Twp. 22 R. 10


Well No. 3 Peacher Farm
Phillips Company

_____ Ft. from N. Line

300 Ft. from S. Line

1120 Ft. from E. Line

_____ Ft. from W. Line

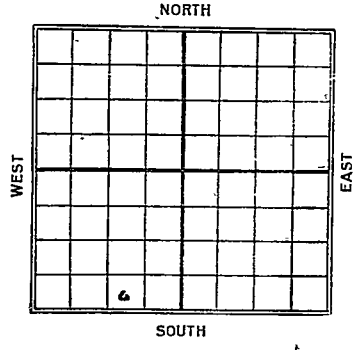

Date 1/14/11

REPORT

8/6

2553-2610
72-2612
P. B 2591
80/15B66

Map No. **KANSAS** ²¹ Sec. **30** Twp. **22** R. **10**

Well No. **3 Prather**

Phillips Company

Contractor

**FIRST REGION
COMPLETED**
Ft. from N. Line

SECTION PLAT

200 Ft. from S. Line

1120 Ft. from E. Line

Ft. from W. Line

COMPLETED

	0		

Location

Rig up

Drilling and Remarks:

2553-2610
J.D. 2612
P.B. 2598
80/15

RECORD

Cased _____ in., _____ ft.

Sand _____

Gas _____

Oil _____

Total Depth _____

PRODUCTION

1st 24 hrs. Nat. _____

1st 24 hrs. after shot _____

Gas _____ Cu. Ft.

Dry Hole _____

Abandoned _____

Date **AUG 6 1924**

M. A. BENEAR

_____ 192_____

Scout