



Map No. *Kaw* Sec. *30* Twp. *22* R. *10*

Well No. *6 Prather* Farm

*CW Titus* Company


*330* Ft. from N. Line

\_\_\_\_\_ Ft. from S. Line

\_\_\_\_\_ Ft. from E. Line

*330* Ft. from W. Line

*C*

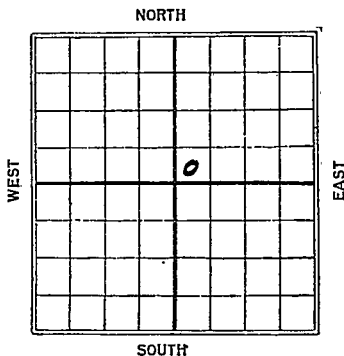

Date	REPORT
<i>1925</i>	
<i>6/12</i>	<i>Blg. rig</i>
<i>6/19</i>	<i>Rig up</i>
<i>6/26</i>	<i>500</i>
<i>7/3</i>	<i>S.D. 600</i>
<i>7/10</i>	_____
<i>7/15</i>	<i>650</i>
<i>7/24</i>	<i>S.D. 650</i>
<i>7/31</i>	<i>✓ ✓</i>
<i>8/7</i>	_____
<i>8/14</i>	_____
<i>7/19</i>	
<i>8/20</i>	<i>Abandoned 650</i>

Map No. 15000 Sec. 30 Twp. 22 R. 10  
 Well No. 6 Alkthel  
C. W. Litus Company

Contractor

SECTION PLAT

330

Ft. from N. Line

Ft. from S. Line

Ft. from E. Line

330

Ft. from W. Line

		0	

FIRST REPORTS

Location -----

Rig up -----

Drilling and Remarks:

*Blodg Rig*

RECORD

Cased \_\_\_\_\_ in., \_\_\_\_\_ ft.

Sand -----

Gas -----

Oil -----

Total Depth -----

PRODUCTION

1st 24 hrs. Nat. -----

1st 24 hrs. after shot -----

Gas ----- Cu. Ft.

Dry Hole -----

Abandoned -----

Date

JUN 12 1925

CHAS. L. SHERWOOD

192

Scout

*W. Sherwood Co*

Map No. *21* KANSAS Sec. *30* Twp. *22* R. *10*

Well No. *6* *Knather*

*O. W. Litus*

Company

Contractor

COMPLETED

SECTION PLAT

Ft. from N. Line

*330*

Ft. from S. Line

Ft. from E. Line

*330*

Ft. from W. Line

ABANDONED

		o	

Location \_\_\_\_\_

Rig up \_\_\_\_\_

Drilling and Remarks:

*shot 650'*

RECORD

Cased \_\_\_\_\_ in., \_\_\_\_\_ ft.

Sand \_\_\_\_\_

Gas \_\_\_\_\_

Oil \_\_\_\_\_

Total Depth *650*

PRODUCTION

1st 24 hrs. Nat. \_\_\_\_\_

1st 24 hrs. after shot \_\_\_\_\_

Gas \_\_\_\_\_ Cu. Ft.

Dry Hole \_\_\_\_\_

Abandoned

Date

AUG 20 1925

192

CHAS. L. SHERWOOD

Scout