


SECTION 30 TOWNSHIP 22S RANGE 11E

WELL NO. #1 Coffman "A"

COMPANY John M. Reilly

NORTH C S/2 NW NE

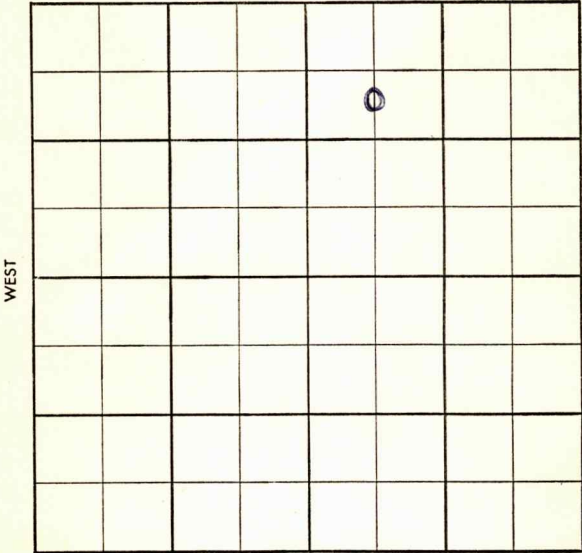

2

SOUTH

Twp ~~X~~ Pool ~~X~~
 Co. ~~X~~ Facet ~~X~~

1 S-513-B

County Greenwood Elev. _____
 Sec. 30 Twp. 22 Rge. 11E
 Company John M. Reilly
 Farm Name Coffman "A" No. 1

TOPS	DEPTH	LOG	DATUM
Anh.			
Tp.			
H.			
Tr.			
Dg.			
B.L.			
L.	<u>1117</u>		
K.C.	<u>1380</u>		
B.K.C.			
Ce.			
C.	<u>No Bant</u>		
M.			
M.			
K.			
Mz.			
Mq.			
V.			
S.			
S.			
A.			
R.			
Pf.			
G.			
T.D.	<u>2109</u>		

Loc. in Sec. _____
C S/2 NW NE
1062' fnl x
1920' fal
 Geol. _____
 Contr. _____
J & J tools
 Pool LeMal lorie
Sowder



Date Comm. 7-6-58
8" @ 100 drlg. under surface TITE HOLE
JUL 16 '58 Tops Log 2065-2109
full rec No ts ts in log

D&A

Co. Use. No. Sec. T. R.

~~Twp. _____~~ ~~Pool. _____~~
~~Co. _____~~ ~~Facet. _____~~

S-513-B

County Greenwood Elev. _____
 Sec. 30 Twp. 22 Rge. 11E
 Company John M. Reilly
 Farm Name Coffman "A" No. 1

TOPS	DEPTH	LOG	DATUM
Anh.			
Tp.			
H.			
Tr.			
Dg.			
B.L.			
L.			
K.C.			
B.K.C.			
Ce.			
C.			
M.			
M.			
K.			
Mz.			
Mq.			
V.			
S.			
S.			
A.			
R.			
Pf.			
G.			
T.D.			

Loc. in Sec. _____
C S/2 NW NE
1062' fnl x
1920' fcl

Geol. _____
 Contr. _____
J & J tools
 Pool DeMal lorie
Sowder

	0
FIRST REPORT	
JUL	9 '58

Date Comm. 7-6-58
8" @ 100 drlg. under surface TITE HOLE

Co. _____
 Lse. _____
 No. _____
 Sec. _____
 T. _____
 R. _____