




Section 30 Township 22 Range 11-E

Well No. #1 Heme

Company Jones & Hill

Miscellaneous  
NORTH

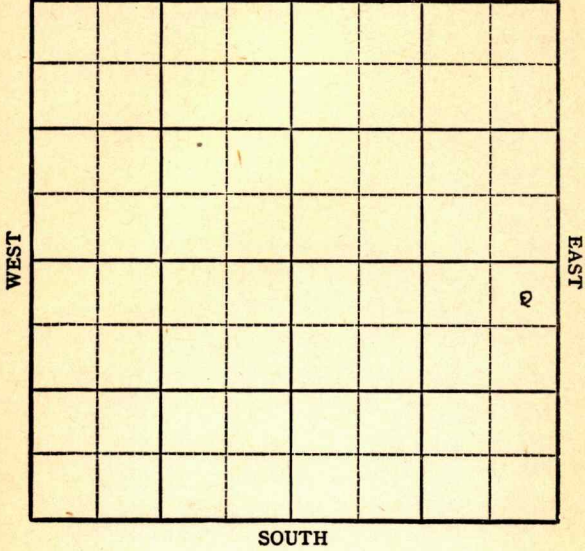

**KANSAS**

Greenwood



Sec. 30 Twp. 22 R. 11E

Well No. #1 Heme Farm

Jones & Hill Company

Miscellaneous


330' Ft. from N. Line

\_\_\_\_\_ Ft. from S. Line

330' Ft. from E. Line

\_\_\_\_\_ Ft. from W. Line

NE SE

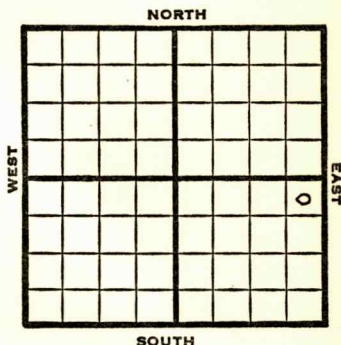

1948

**Eli**

REPORT

12/1

**Bart 2039'**

TD 2082'

5" @ 2039'

20 qts.

Cleaning out

12/8

TD 2082'

**Bart 2059'**

5" @ 2039'

Pump 25 Oil Pot

38° Gr.

Comp

**COMPLETED**

Map No. \_\_\_\_\_ Sec. 30 Twp. 22 R. 11E

Well No. 1 Home

Jones & Hill Company

FIRST REPORT Contractor

NE SE

SECTION PLAT

330 Ft. from N. Line

\_\_\_\_\_ Ft. from S. Line

330 Ft. from E. Line

\_\_\_\_\_ Ft. from W. Line

			o

Greenwood County

Location \_\_\_\_\_

Rig up \_\_\_\_\_

Drilling and Remarks:

Bart. 2039

TD 2082

5" @ 2039

20 qts.

cleaning out

RECORD

Cased \_\_\_\_\_ in., \_\_\_\_\_ ft.

Sand \_\_\_\_\_

Gas \_\_\_\_\_

Oil \_\_\_\_\_

Total Depth \_\_\_\_\_

PRODUCTION

1st 24 hrs. Nat. \_\_\_\_\_

1st 24 hrs. after shot \_\_\_\_\_

Gas \_\_\_\_\_ Cu. Ft.

Dry Hole \_\_\_\_\_

Abandoned \_\_\_\_\_

Date

DEC 1 1948

19

S. J. LEWIS Scout

Map No. 21 Sec. 30 Twp. 22 R. 11E

Well No. 1 Heme

Jones & Hill Company

COMPLETE Contractor

NE SE

SECTION PLAT

330 Ft. from N. Line

\_\_\_\_\_ Ft. from S. Line

330 Ft. from E. Line

\_\_\_\_\_ Ft. from W. Line

			o

Greenwood County

Location \_\_\_\_\_

Rig up \_\_\_\_\_

Drilling and Remarks:

*Bar 72039*

*5" @ 2039*

*Pung 2500 ft*

*280 ft*

RECORD

Cased \_\_\_\_\_ in., \_\_\_\_\_ ft.

Sand \_\_\_\_\_

Gas \_\_\_\_\_

Oil  \_\_\_\_\_

Total Depth 2039

PRODUCTION

1st 24 hrs. Nat. \_\_\_\_\_

1st 24 hrs. after shot \_\_\_\_\_

Gas \_\_\_\_\_ Cu. Ft.

Dry Hole \_\_\_\_\_

Abandoned \_\_\_\_\_

Date

DEC 8 1948 19

S. J. LEWIS Scout