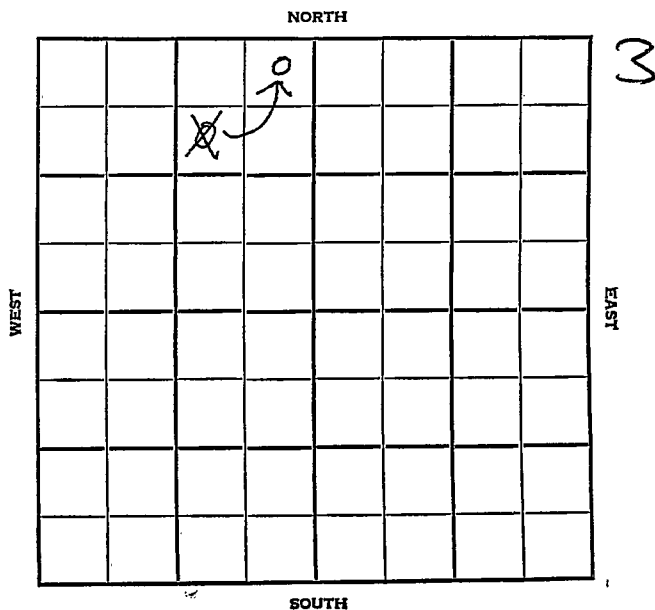


Section 31 Township 22 S Range 14 EWell No. #6 Edmonds HeirsCompany Beaumont Petroleum Co.

Marion

KANSAS

SEC.	TWP.	R.
31	22S	4E

WELL NO.

#6 Edmonds Heirs

FARM

COMPANY

Beaumont Petroleum Co.

CONTRACTOR

Co.


Edmonds

330 Ft. from N. Line

Ft. from S. Line

330 Ft. from E. Line

Ft. from W. Line

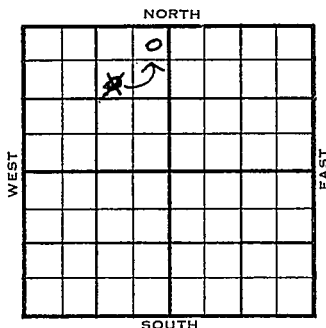NE
SW NE NW

1955	ELEVATION 1407'	REPORT FIRST REPORT
------	--------------------	---------------------

8/10 MIRT

9-14 Comm. 8-7-55

8 5/8" @ 92/60

5 1/2" @ 2476/30

DD 2493 FU 600' wtr. 14 hr. FU 650'
fluid 36 hr., 40' oil, DD 2495 wtr.

PB 2486 frac 8/ 2474-76, frac wtr.

D & A

<u>Tops</u>	<u>Depth</u>
-------------	--------------

L. 1892

B.K.C. 2263

Ce. 2437

M. 2475

T.D. 2476'

ABANDONED

County Marion Elev. _____
 Sec. 31 Twp. 22S Rge. 4E
 Company Beaumont Petroleum Co.
 Farm Name Edmonds Heirs No. 6

TOPS

DEPTH

LOG

DATUM

Loc. in Sec. _____

Anb.

SW NE NW

Tp.

H.

Tr.

Dg.

Bl.

L.

K.C.

Geol. _____

B.K.C.

Contr. Co.

Ce.

C.

M.

M.

Pool _____

K.

Edmonds

Mz.

Mq.

V.

S.

S.

A.

R.

P.E.

G.

T.D.

AUG 10 '55

FIRST REPORT

Date Comm. MRT

SCOUT TICKET

DX-201

Kansas

SEC.

TWP.

R.

31

22

1E

WELL NO.

6 Edmonds Heirs

FARM

COMPANY

Beaumont Pet. Co.

CONTRACTOR

CORRECTION

NE NE NW


330 FT. FROM N. LINE

FT. FROM S. LINE

330 FT. FORM E. LINE

FT. FROM W. LINE

NORTH

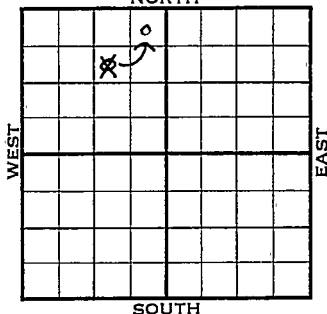

Marion County

☐

LOCATION

☐

RIG UP

DRILLING AND REMARKS:

Reported
SW NE NW

RECORD

CASED IN., FT.

SAND

GAS

OIL

TOTAL DEPTH

1ST 24 HRS. NAT.

1ST 24 HRS. AFTER SHOT

GAS CU. FT.

DRY HOLE

ABANDONED

PRODUCTION

DATE


AUG 1 7 1955

SCOUT

L. J. Harris

County Marion Elev. 1407
 Sec. 31 Twp. 22 Rge. 4E
 Company Beaumont Petroleum Co.
 Farm Name Edmonds Heirs No. 6

TOPS	DEPTH	LOG	DATUM	Loc. in Sec.
Anh.				NE NE NW
TP.				
H.				
Tr.				
Dg.				
Bl.				
L.	1892		485	Geol.
K.C.				Contr.
B.K.C.	2263		856	Co. tools
Ce.	2437		1030	Pool
C.				Edmonds
M.	2475		1068	
M.				
K.				
Mz.				
Mo.				
V.				
S.				
S.				
A.				
R.				
PE.				
G.				
T.D.	2476			

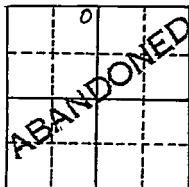

Date Comm. 8-7-55 SEP 14 1955

8 5/8" @ 92/60 5 1/2" @ 2476/30

DD 2493 FU 600' wtr. 14 hr.

FU 650' fluid 36 hr. 40' oil

DD 2495 wtr. PB 2486 frac

8/ 2474-76 frac wtr

D & A