


Section 31 Township 22 Range 4E

Well No. #1 Hawk

Company Aladdin Pet. et al

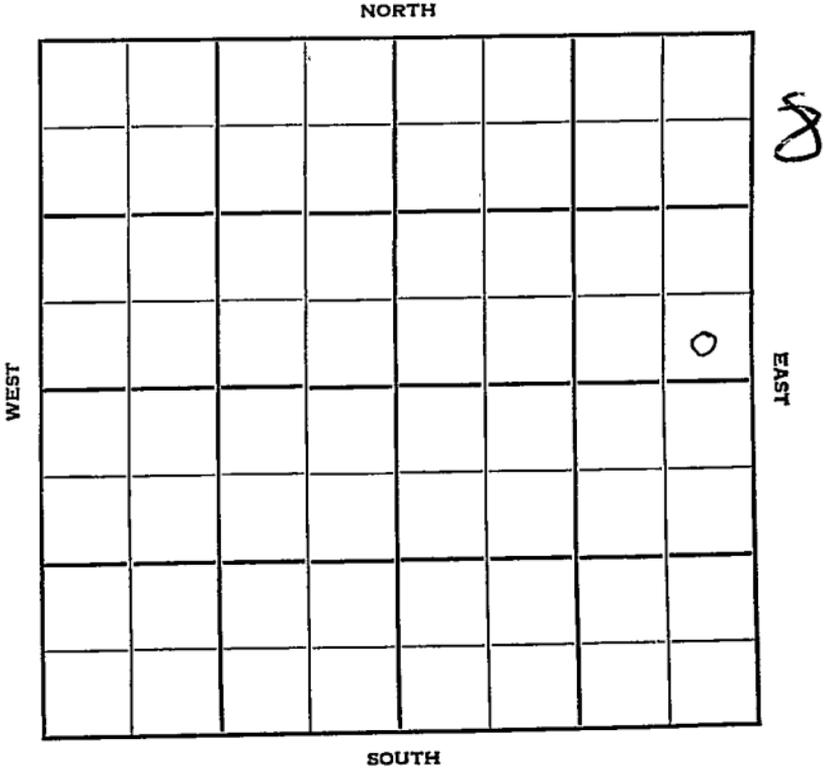

Marion

KANSAS
4 E ✓

Sec. 31 Twp. 22 R. 4 E

Well No. # 1 Hawk Farm

Aladdin Pet. et al Company

Contractor

Wildcat


Ft. from N. Line

330 Ft. from S. Line

330 Ft. from E. Line

Ft. from W. Line

SE SE NE

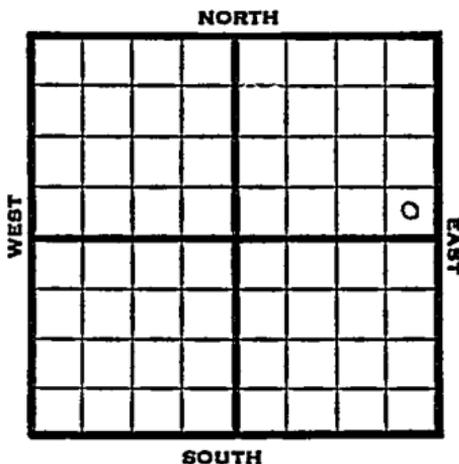

1951

Elev. -

REPORT

8/22

R U R

9/12

Spud 8-24-51

D&A TD 2864

8-5/8" @ 94'

DST 2468-74 opr 1/2 hr

Rec. 30' sgcM Hunton 2613

Viola 2698 Lans. 1563

KC 1871 Miss 2465

Kh 2512 Maq 2683

Simp 2768 Arb. 2829-64 TD

D&A

ABANDONED

County Marion State Kansas

Sec. 31 (Blk. 22 (Sur. Rge.) 4E Map No.

Operator Aladdin Pet. etal.

Well No. 1 Farm Hawk

Elev. _____ Location SE SE NE

330 Ft. From S Line NE

330 Ft. From T Line Quarter

Ist. Report AUG 22 1951

Completion _____

Remarks _____

Spudding Date _____

Drig. Data Wildcat

RUR

J. E. TYRA


County Marion State Kansas

Sec. 31 (^{Blk.}22) (^{Sur.}4E) Map No.

Operator Aladdin Pet. etal.

Well No. 1 Farm Hawk

Elev. Location SE SE NE

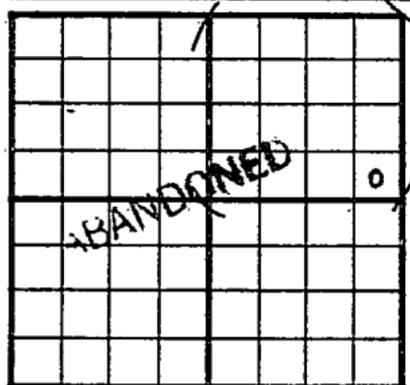

330 Ft. From S Line NE

330 Ft. From E Line Quarter

1st. Report

Completion SEP 12 1951

Remarks Wildcat

Spudding Date 8-24-51

Drig. Data D & A TD 2864

8 5/8" @ 94 DST 2468-74 open 1/2 hr.

Rec. 30' sgcm Hunton 2613 Viola 2698

Lans. 1563 KC 1871 Miss. 2465

Kh. 2512 Mag. 2683 Simp. 2768

Arb. 2829-64 TD

D & A