


Section 31 Township 22 Range 4E

Well No. #1 Hawk

Company K. T. Weidemann

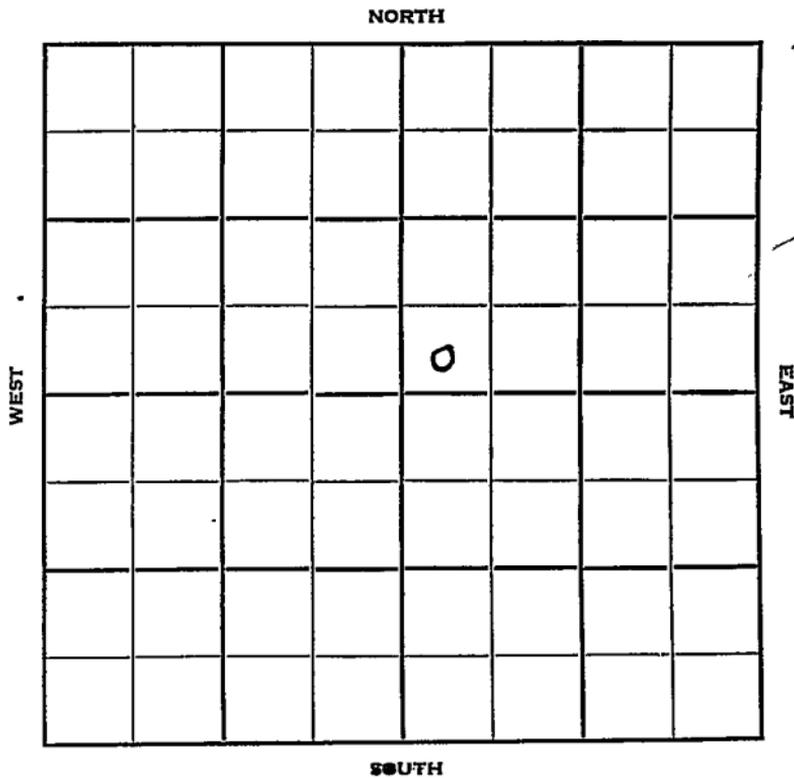

Sec. 31 Twp. 22 R. 4 E

Well No. # 1 Hawk Farm

K. T. Weidemann Company

Contractor


Ft. from N. Line

330 Ft. from S. Line

Ft. from E. Line

330 Ft. from W. Line

SW SW NE

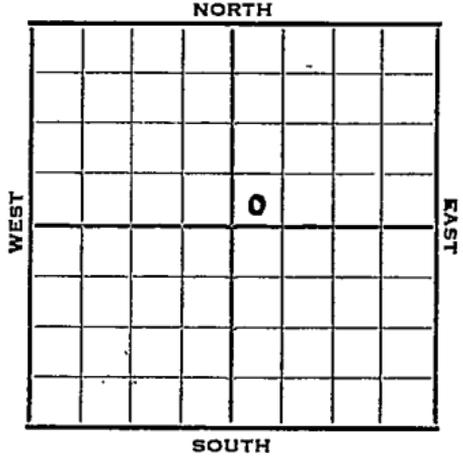

1952

Elev. 1394 REPORT

7/9

Drig. 2100'

9/4

Temp Aban . TD 2501
8" @ 73 KC 2047
Miss 2448 Marm 2289
DST 2446-60 opn 3/4 hr.
Rec. 12' mud
DST 2446-2500 opn 3/4 hr.
Rec. 315' hocm TD 2500
5" @ 2446 CO to 2501
15 bo 15 bw 8 hr. Sd-frac
CO to 2464 S/fluid 15 bopd
15 bw Temp Aband.

ABANDONED

O.W.W.O.

1953

4/1

Miss 2446' OTD 2501' 5" @ 2448
CO to 2464 Pay 2460-64'
P/5 BOPD

4/22

Oil Well
TD 2501
Miss 2446
OTD 2501
5" @ 2448
CO to 2464
Pay 2460-64'
P/5 bopd
P/4 bopd & 4 bwpd
Comp. 7 bopd 20 bw

COMPLETED

