


Marion

KANSAS

SECTION 31 - TOWNSHIP ~~##~~ 22 RANGE 4E

WELL NO. #1 Liggett

COMPANY Beaumont Petr.

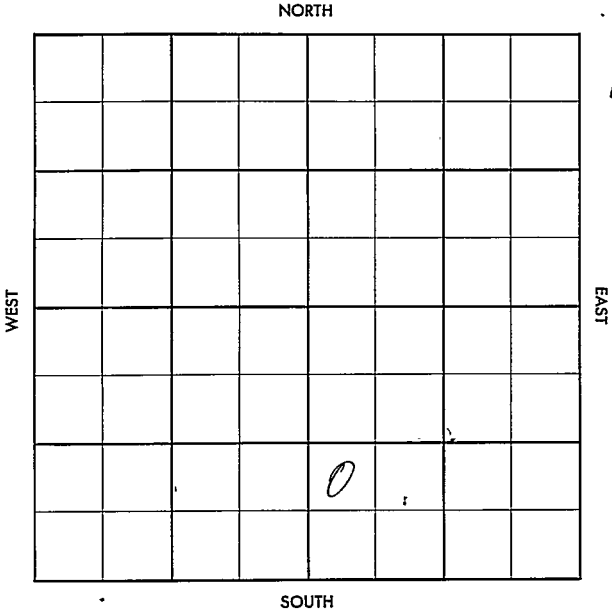

Marion

KANSAS

SEC. 31	TWP. - 22	R. 4E
------------	--------------	----------

WELL NO.

#4 Liggett

FARM

COMPANY

Beaumont Petr.

CONTRACTOR

Co. Tools

Edmonds


_____ Ft. from N. Line

_____ Ft. from S. Line

_____ Ft. from E. Line

_____ Ft. from W. Line

NW SW SE

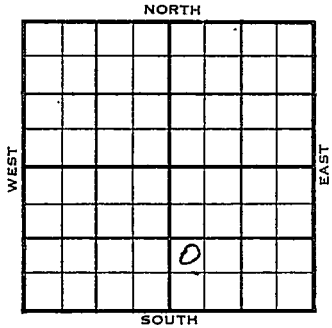

1956

ELEVATION
1400'

REPORT

5-9

Comm. 4-3-56
8" @ 100 w/75
Drlg. 1600

5-29

5 1/2" @ 2448'
DD 2460
Frac
Est. P/ 15 bopd, / 8 bwpd
L. 1881', BKG 2258', Marm 2312',
Sdy 2434', Cht 2446
TD 2450'

COMPLETED

County Marion Elev. _____
 Sec. 31 Twp. 22 Rge. 4E
 Company Beaumont Pet.
 Farm Name Liggett No. 4

TOPS	DEPTH	LOG	DATUM
Anh.			
Tp.			
H.			
Tr.			
Dg.			
Bl.			
L.			
K.C.			
B.K.C.			
Ce.			
C.			
M.			
M.			
K.			
Mz.			
Me.			
V.			
S.			
S.			
A.			
R.			
PE.			
G.			
TR.			

Loc. in Sec. NW SW SE

Geol. _____
 Contr. Co. tools

Pool Edmonds

FIRST REPORT		
MAY	9	56
	0	

Date Comm. 11-3-56
8" @ 100/75 drlg. 1600

3201 J. P. VACA

1956

[Handwritten signature]

Co.

Lse.

No.

Sec.

T.

R.

Co.

County Marion Elev. 1400
 Sec. 31 Twp. 22 Rge. 4E
 Company Beaumont Pet.
 Farm Name Liggett No. 4

TOPS	DEPTH	LOG	DATUM
Anh.			
TP.			
H.			
Tr.			
Dg.			
Bl.			
L.	<u>1881</u>		<u>1881</u>
K.C.			
B.K.C.	<u>2258</u>		<u>2258</u>
Ce.	<u>Marm</u> <u>2312</u>		<u>912</u>
C.	<u>sdg</u> <u>2434</u>		<u>1024</u>
M.	<u>cht</u> <u>2446</u>		<u>2046</u>
M.			
K.			
Mz.			
Ma.			
V.			
S.			
S.			
A.			
R.			
PE.			
G.			
T.D.	<u>2450</u>		

Loc. in Sec. NW SW SE

Geol. _____
 Contr. _____
 Co. tools _____

Pool Edmonds

COMPLETE

Sec.

No.

Sec.

T.

R.

Date Comm. 1-3-56 MAY 29 1956

8" @ 100/75 drlg. 1600 MAY 16 '56

5 1/2 "2448/ MAY 23 '56 CO MAY 29 '56 DD

2460 Frac. est P. 15 BOPd +
8 BWPd.